

SURVEY & REMONUMENTATION

FEB 17 1998

BARRY COUNTY REMONUMENTATION

LAND CORNER RECORDATION CERTIFICATE
Filing Requirement of Act 74, Mich. P.A. 1970

SECTION

For Corners in BARRY Located In: _____ Corner Code # _____
(county)



2602
Page: 1 of 1
09/16/1997 11:48

1. Public Land Survey T 1N R 7W M-2
EAST 1/4 CORNER T R
SECTION 1 T R
ASSYRIA TOWNSHIP T R
ON RANGE LINE
2. Property Controlling S _____ T _____ R _____
in Section S _____ T _____ R _____
3. Miscellaneous S _____ T _____ R _____
Property in Sec. S _____ T _____ R _____
4. Lot No _____, Recorded Plat _____
5. Private Claims _____

Sandy Schondelmayer - Barry Co. LCRCR

Register of Deeds Stamp & File Number

I, **Brian Reynolds**, in a field survey on **31 JULY, 1997** do hereby certify that under requirements of P.A. 74, Michigan P.A. of 1970, the corner points mentioned in lines 1 and 2 above were in conformance with regulations and rules therefore as required in the current manual of survey instructions of the United States Department of the Interior, Bureau of Land Management or by a decree of a Court of Law and/or that the corner points mentioned in lines 3, 4, and 5 above were in conformance with the rules of the Michigan Board of Land Surveyors or by a Decree of a Court of Law; established, re-established, monumented, re-monumented, recovered, found as expressed below.

	A	B	C	D	E	F	G	H	I	J	K	L	M
2	6	5	4	3	2	1							
3													
4	7	8	9	10	11	12							
5													
6	18	17	16	15	14	13							
7													
8	19	20	21	22	23	24							
9													
10	30	29	28	27	26	25							
11													
12	31	32	33	34	35	36							
13													

NOTE: Not more than 2 corners, all in the same town and range, may be recorded on this certificate.

A. Description of original monument and accessories and/or subsequent restoration:

- GENERAL LAND OFFICE: JOHN MULLETT, D.S., 1825 (R7W, P.6), BEECH 16 S12W 15 Do. 7 N20W 55
 - COUNTY SURVEYOR RECORDS: BOWEN, 13-14-15 NOV. 1878 (L.1,267) "SET STONE & BRICK"
- *** NO OTHER HISTORICAL INFORMATION, PUBLIC OR PRIVATE, AVAILABLE FOR THIS CORNER ***

B. Description of corner evidence found and/or method applied in restoring or reestablishing corner:


FOUND NO MAGNETIC EVIDENCE OF CORNER MONUMENTATION. EXCAVATION WITH BACKHOE REVEALED NOTHING. CORNER LIES IN A 3'+ FILL AREA 10' +/- NORTH OF A CULVERT. ANY EVIDENCE OF CORNER MONUMENTATION MAY HAVE BEEN DESTROYED BY ROAD CONSTRUCTION OR CULVERT INSTALLATION. FOUND STONE 819.19 FEET NORTH OF M-2 (TITLE CORNER) BY COUNTY SURVEYOR FRANK BOWEN (FROM SURVEY ITEM # 2 ABOVE). HELD STONE AND PREVIOUSLY APPROVED M-1 FOR RANGE LINE, INTERSECTED RANGE LINE WITH 1/4 LINE OCCUPATION FENCE FROM THE WEST. POSITION THUS ESTABLISHED PROVES CONSISTENT WITH BOWEN'S SURVEY (ITEM #2 ABOVE). THIS METHOD PROVES CONSISTENT WITH BOWEN'S SURVEY. ACCEPTED AS PROPER RESTORATION OF CORNER POSITION. SET STANDARD BARRY COUNTY REMONUMENTATION MONUMENT.

C. Description of monument for corner and accessories established to perpetuate locating the position of the corner:

- SET STANDARD BARRY COUNTY REMONUMENTATION MONUMENT (3/4" X 36" IRON) WITH ALUMINUM CAP.
- SET 20d NAIL W/PLASTIC TAG IN THE SOUTHEAST SIDE OF A 12" ASH N49°E 21.01'
- SET 20d NAIL W/PLASTIC TAG IN THE WEST SIDE OF AN 8" TRIPLE ASH N16°E 68.97'
- SET 20d NAIL W/PLASTIC TAG IN THE WEST SIDE OF A 6" ASH N18°E 61.77'
- SET 20d NAIL W/PLASTIC TAG IN THE SOUTH SIDE OF A 6" ASH N70°E 24.26'
- SET 20d NAIL W/PLASTIC TAG IN THE EAST SIDE OF A 24" TWIN BASSWOOD S07°W 138.49'
- CORNER LIES 3'+/- EAST OF NORTH-SOUTH CENTERLINE IN LINE WITH FENCE TO THE WEST
- A-2, T1N, R6W, LIES N00°07'30"E 99.44'

ACT 345 BARRY COUNTY REMONUMENTATION
APPROVED BY PEER REVIEW AT A MEETING HELD ON

11 Aug. '97 BR
BRIAN REYNOLDS COUNTY SURVEYOR

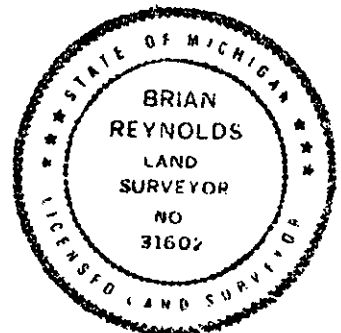

Signed by [Signature]
Surveyor's Michigan License No 31602

Date 9/15/97