

**SURVEY & REMONUMENTATION**

JUL 24 1997

COMMISSION

**BARRY COUNTY REMONUMENTATION**

STATE OF MICHIGAN  
COUNTY OF BARRY  
REGISTER OF DEEDS

MAR 5 9 26 AM '97

**LAND CORNER RECORDATION CERTIFICATE**  
Filing Requirement of Act 74, Mich. P.A. 1970

For corners in **BARRY**  
(County)

Located In: Corner Code #

1. Public Land Survey  
**CORNER COMMON TO SECTIONS 1 & 12 ASSYRIA TOWNSHIP ON RANGE LINE**

T 1N R 7W M-3

2. Property Controlling in Section

S      T      R     

3. Miscellaneous Property in Sec.

S      T      R     

San...  
REGISTER OF DEEDS

002492

Register of Deeds Stamp & File Number

4. Lot No. \_\_\_\_\_, Recorded Plat \_\_\_\_\_  
5. Private Claims \_\_\_\_\_

**BRIAN REYNOLDS**

26 APRIL

96

I, \_\_\_\_\_, in a field survey on \_\_\_\_\_, 19 \_\_\_\_\_, do hereby certify that under requirements of P.A. 74, Michigan P.A. of 1970, the corner points mentioned in lines 1 and 2 above were in conformance with regulations and rules therefore as required in the current manual of survey instructions of the United States Department of the Interior, Bureau of Land Management or by a decree of a Court of Law and/or that the corner points mentioned in lines 3, 4 and 5 above were in conformance with the rules of the Michigan Board of Land Surveyors or by a Decree of a Court of Law; established, re-established, monumented, re-monumented, recovered, found as expressed below:

**NOTE: Not more than 4 corners, all in the same town and range, may be recorded on this certificate.**

A	B	C	D	E	F	G	H	I	J	K	L	M
2	6	5	4	3	2	1						
3												
4	7	8	9	10	11	12						
5												
6	18	17	16	15	14	13						
7												
8	19	20	21	22	23	24						
9												
10	30	29	28	27	26	25						
11												
12	31	32	33	34	35	36						
13												

A. Description of original monument and accessories and/or subsequent restoration:

1. GENERAL LAND OFFICE: JOHN MULLETT, D.S., 1825 (R.7W,P.6) SUG. 10 S12W 18 BEECH 7 N46 1/2W 14
2. COUNTY SURVEYOR RECORDS: BOWEN, NOV. 1878 (L.1,P.267) "STONE FOR CORNER" ELM 16 S75E 92 SWAMP OAK 0.4 N37 1/2W 1.21

**NO OTHER RECORDED HISTORICAL INFORMATION AVAILABLE FOR THIS CORNER**

B. Description of corner evidence found and/or method applied in restoring or reestablishing corner:

**FOUND 1/2" IRON ROD AT APPROXIMATE CENTERLINE OF NORTH-SOUTH GRAVEL ROAD AND APPROXIMATE CENTERLINE OF GRAVEL ROAD WEST. TOOK NEW WITNESSES THEN EXCAVATED WITH A BACKHOE AN AREA 8' E-W BY 12' N-S TO A DEPTH OF 3+ FEET, FOUND NO ADDITIONAL EVIDENCE. DISTANCE TO OCCUPATION AT A-2 (2650+/-) IS CONSISTENT WITH DISTANCE TO FOUND 1/2" IRON SOUTH (2644.55').**

**ACCEPTED FOUND 1/2" IRON ROD AS BEST EVIDENCE OF CORNER POSITION.**


**SET STANDARD BARRY COUNTY REMONUMENTATION MONUMENT FROM WITNESSES.**

ACT 345 BARRY COUNTY REMONUMENTATION  
APPROVED BY PEER REVIEW AT A MEETING HELD ON

5-13-96

BR

BRIAN REYNOLDS COUNTY SURVEYOR

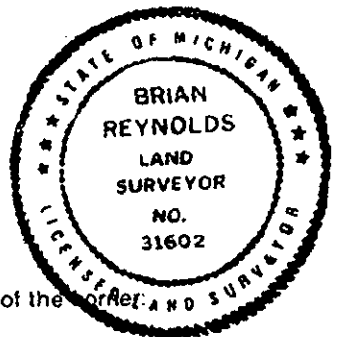

C. Description of monument for corner and accessories established to perpetuate the position of the corner:

- SET STANDARD BARRY COUNTY REMONUMENTATION MONUMENT (WITH ALUMINUM CAP)
- SET 20d NAIL W/REMON TAG IN THE SOUTH SIDE OF A 12" BLACK WALNUT N62°W 39.60'
- SET 20d NAIL W/REMON TAG IN THE EAST SIDE OF A 6" TWIN BLACK WALNUT N48°W 49.91'
- SET 20d NAIL W/REMON TAG IN THE EAST SIDE OF A 26" OAK N22°W 60.78'
- SET 20d NAIL W/REMON TAG IN THE WEST SIDE OF A 10" BLACK OAK N20°E 46.78'
- SET CHISELED "X" IN THE TOP CENTER OF A 24" x 24" CONCRETE MONUMENT N34°E 49.61'
- FOUND 1917 U.S. GEOLOGICAL SURVEY BRASS CAPPED BENCH MARK N28°W 56.15'
- A-3 TOWN 1 NORTH, RANGE 6 WEST LIES NORTH 99.66'
- ROUGHLY ON CENTERLINE OF NORTH-SOUTH-WEST GRAVEL ROADS

Signed by *BR*

FEB 18 1997