

SURVEY & REMONUMENTATION

BARRY COUNTY REMONUMENTATION

JUL 24 1997

COMMISSION

LAND CORNER RECORDATION CERTIFICATE
Filing Requirement of Act 74, Mich. P.A. 1970

STATE OF MICHIGAN
COUNTY OF BARRY
REGISTER OF DEEDS

MAR 5 9 26 AM '97

Sandy J. ...
REGISTER OF DEEDS

For corners in **BARRY**
(County)

Located In: Corner Code #

1. Public Land Survey	T	<u>1N</u>	R	<u>7W</u>	M-4
EAST 1/4 CORNER SECTION	T		R		
12 ASSYRIA TOWNSHIP	T		R		
ON RANGE LINE	T		R		
2. Property Controlling in Section	S		T		R
3. Miscellaneous Property in Sec.	S		T		R

002493

Register of Deeds Stamp & File Number

- 4. Lot No. _____, Recorded Plat _____
- 5. Private Claims _____

	A	B	C	D	E	F	G	H	I	J	K	L	M
2	6	5	4	3	2	1							
3													
4	7	8	9	10	11	12							
5													
6	18	17	16	15	14	13							
7													
8	19	20	21	22	23	24							
9													
10	30	29	28	27	26	25							
11													
12	31	32	33	34	35	36							
13													

I, **BRIAN REYNOLDS**, in a field survey on **26 APRIL**, 19**96**, do hereby certify that under requirements of P.A. 74, Michigan P.A. of 1970, the corner points mentioned in lines 1 and 2 above were in conformance with regulations and rules therefore as required in the current manual of survey instructions of the United States Department of the Interior, Bureau of Land Management or by a decree of a Court of Law and/or that the corner points mentioned in lines 3, 4 and 5 above were in conformance with the rules of the Michigan Board of Land Surveyors or by a Decree of a Court of Law; established, re-established, monumented, re-monumented, recovered, found as expressed below:

NOTE: Not more than 4 corners, all in the same town and range, may be recorded on this certificate.

A. Description of original monument and accessories and/or subsequent restoration:

- 1. GENERAL LAND OFFICE: JOHN MULLETT, D.S., 1825 (R7W, P.5) SUG. 8 S13W 16 Do. 9 N15W 15
- 2. COUNTY SURVEYOR RECORDS: BOWEN (ASSYRIA FIELD BOOK, PAGE 1(NO DATE)) BEECH 12 N71W 1.09 HICK 4 N44W 93

NO OTHER RECORDED HISTORICAL INFORMATION AVAILABLE FOR THIS CORNER.

B. Description of corner evidence found and/or method applied in restoring or reestablishing corner:

FOUND 1/2" IRON ROD AT APPROXIMATE CENTERLINE OF NORTH-SOUTH GRAVEL ROAD AND APPROXIMATE CENTERLINE OF GRAVEL ROAD WEST. EXCAVATED WITH A BACKHOE AN AREA 8' E-W BY 12' N-S TO A DEPTH OF 3+ FEET, FOUND NO ADDITIONAL EVIDENCE. DISTANCES TO FOUND IRON NORTH (2644.55') IS CONSISTENT WITH DISTANCE TO FOUND IRON SOUTH (2644.11').


ACCEPTED FOUND 1/2" IRON ROD AS BEST EVIDENCE OF CORNER POSITION.

ACT 345 BARRY COUNTY REMONUMENTATION
APPROVED BY PEER REVIEW AT A MEETING HELD ON

5-13-96 BR
BRIAN REYNOLDS COUNTY SURVEYOR

C. Description of monument for corner and accessories established to perpetuate locating the position of the corner:

- SET STANDARD BARRY COUNTY REMONUMENTATION MONUMENT (WITH ALUMINUM CAP)
- SET 20d NAIL W/REMON TAG IN THE EAST SIDE OF AN 8" CHERRY S28°W 61.28'
- SET 20d NAIL W/REMON TAG IN THE NORTH SIDE OF AN 8" CHERRY S62°W 63.49'
- SET 20d NAIL W/REMON TAG IN THE EAST SIDE OF A 6" MAPLE N57°W 66.60'
- SET 20d NAIL W/REMON TAG IN THE WEST TRUNK OF A 3" TWIN MAPLE N31°W 64.32'
- SET 20d NAIL W/REMON TAG IN THE WEST SIDE OF A 4" MAPLE N20°W 72.06'
- ROUGHLY ON CENTERLINE NORTH-SOUTH-WEST GRAVEL ROADS
- CENTERLINE OF GRAVEL ROAD EAST LIES NORTH 63'+/-

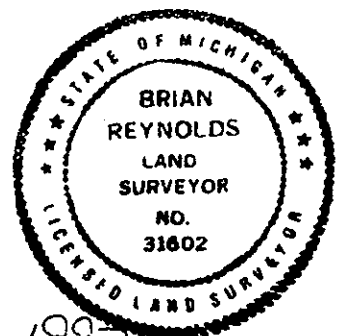

Signed by [Signature]
Surveyor's Michigan License No. 31602

Date FEB 18, 1997