

**SURVEY & REMONUMENTATION**

JUL 24 1997

COMMISSION

**BARRY COUNTY REMONUMENTATION**

**LAND CORNER RECORDATION CERTIFICATE**  
Filing Requirement of Act 74, Mich. P.A. 1970

STATE OF MICHIGAN  
COUNTY OF BARRY  
REGISTER OF DEEDS

MAR 5 9 26 AM '97

Samuel J. ...  
REGISTER OF DEEDS

For corners in **BARRY**  
(County)

Located In: **1N 7W** Corner Code **M-5**

- 1. Public Land Survey **CORNER COMMON TO SECTIONS 12 & 13 ASSYRIA TOWNSHIP ON RANGE LINE**
- 2. Property Controlling in Section
- 3. Miscellaneous Property in Sec.

002494

Register of Deeds Stamp & File Number

- 4. Lot No. \_\_\_\_\_, Recorded Plat \_\_\_\_\_
- 5. Private Claims \_\_\_\_\_

A	B	C	D	E	F	G	H	I	J	K	L	M
2	6	5	4	3	2	1						
3												
4	7	8	9	10	11	12						
5												
6	18	17	16	15	14	13						
7												
8	19	20	21	22	23	24						
9												
10	30	29	28	27	26	25						
11												
12	31	32	33	34	35	36						
13												

I, **BRIAN REYNOLDS**, in a field survey on **26 APRIL**, 19**96**, do hereby certify that under requirements of P.A. 74, Michigan P.A. of 1970, the corner points mentioned in lines 1 and 2 above were in conformance with regulations and rules therefore as required in the current manual of survey instructions of the United States Department of the Interior, Bureau of Land Management or by a decree of a Court of Law and/or that the corner points mentioned in lines 3, 4 and 5 above were in conformance with the rules of the Michigan Board of Land Surveyors or by a Decree of a Court of Law; established, re-established, monumented, re-monumented, recovered, found as expressed below:

**NOTE: Not more than 4 corners, all in the same town and range, may be recorded on this certificate.**

- A. Description of original monument and accessories and/or subsequent restoration:
1. GENERAL LAND OFFICE: JOHN MULLETT, D.S., 1826 (R7W, P.5) BEECH 6 N40W 24 Do. 9 S61W 32
  2. EATON COUNTY L.C.R.C. LIBER 2, PAGE 786, REFERRING TO A-5, T1N, R6W, BY ROBERT R. CARR, "FOUND IRON PIPE AT SOUTHEAST CORNER SECTION 12 T1N, R7W..."
  3. LAND CORNER RECORDATION CERTIFICATE: # 455, BY DANIEL M. RYAN, P.S.#34975, APRIL 27, 1992, "FOUND 3/4" IRON ROD" U-POLE M45"W 46.96 FEET 1/2" IRON ROD S45"W 66.37 FEET 1.5' TO WEST OF CENTERLINE OF N&S ROAD."
- \*\* NOTE \*\* LAND CORNER RECORDATION CERTIFICATE #455 (ABOVE) IS IN ERROR. THE CORNERS RECORDED ARE M-5 AND L-5. CORNER INFORMATION IS TRANSPOSED BETWEEN CORNERS.**
- NO OTHER RECORDED HISTORICAL INFORMATION AVAILABLE FOR THIS CORNER.**

B. Description of corner evidence found and/or method applied in restoring or reestablishing corner:

**FOUND 3/4" IRON ROD AND WITNESSES FROM L.C.R.C. ITEM 3 ABOVE. TOOK ADDITIONAL WITNESSES THEN EXCAVATED WITH A BACKHOE AN AREA 8' E-W BY 12' N-S TO A DEPTH OF 3+ FEET, FOUND NO ADDITIONAL EVIDENCE.**

**ACCEPTED FOUND 3/4" IRON ROD AS BEST EVIDENCE OF CORNER POSITION.**

**SET STANDARD BARRY COUNTY REMONUMENTATION MONUMENT FROM WITNESSES.**


ACT 345 BARRY COUNTY REMONUMENTATION  
APPROVED BY PEER REVIEW AT A MEETING HELD ON

5-13-96

BRIAN REYNOLDS

*BR*

COUNTY SURVEYOR

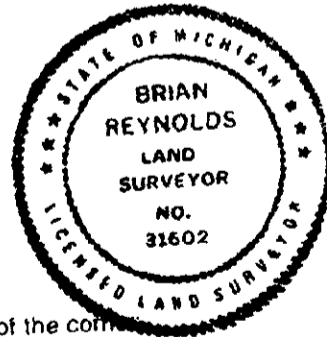

C. Description of monument for corner and accessories established to perpetuate locating the position of the corner:

**SET STANDARD BARRY COUNTY REMONUMENTATION MONUMENT (WITH ALUMINUM CAP)**

- FOUND NAIL IN THE NORTHEAST SIDE OF A 10" ELM N56"W 58.12'
- SET "PK" WIREMON TAG IN THE SOUTHWEST SIDE OF A UTILITY POLE N43"W 47.39'
- SET "PK" WIREMON TAG IN THE SOUTHWEST SIDE OF A WOODEN FENCE POST N51"W 55.26'
- SET "PK" WIREMON TAG IN THE SOUTHWEST SIDE OF A WOODEN FENCE POST N34"W 56.12'
- FOUND 1/2" CAPPED IRON S44"W 56.36'
- A-5 TOWN 1 NORTH, RANGE 6 WEST LIES NORTH 69.96'
- CORNER IS ROUGHLY ON CENTERLINE NORTH-SOUTH GRAVEL ROAD CENTERLINE GRAVEL ROAD WEST LIES SOUTH 2'+/-
- SEE REVERSE OF THIS FORM FOR RELATIVE POSITION OF NEARBY GRID CORNERS

Signed by *Brian Reynolds*

Date **FEB 18, 1997**