

SURVEY & REMONUMENTATION

BARRY COUNTY REMONUMENTATION

AUG 13 1998

LAND CORNER RECORDATION CERTIFICATE
Filing Requirement of Act 74, Mich. P.A. 1970

For Corners in SECTION BARRY (county)

Located In:

Corner Code



2679 Page: 1 of 1 04/23/1998 08:10

Sandy Schondelmayer - Barry Co. LCRCR

- 1. Public Land Survey EAST 1/4 CORNER SECTION 13 ASSYRIA TOWNSHIP ON RANGE LINE
2. Property Controlling in Section
3. Miscellaneous Property in Sec.
4. Lot No. Recorded Plat
5. Private Claims

Register of Deeds Stamp & File Number

Table with 13 rows and 12 columns (A-L) for recording corners.

I, Brian Reynolds, in a field survey on 8 JULY, 1997 do hereby certify that under requirements of P.A. 74, Michigan P.A. of 1970, the corner points mentioned in lines 1 and 2 above were in conformance with regulations and rules therefore as required in the current manual of survey instructions of the United States Department of the Interior, Bureau of Land Management or by a decree of a Court of Law and/or that the corner points mentioned in lines 3, 4, and 5 above were in conformance with the rules of the Michigan Board of Land Surveyors or by a Decree of a Court of Law; established, re-established, monumented, re-monumented, recovered, found as expressed below.

NOTE: Not more than 2 corners, all in the same town and range, may be recorded on this certificate.

A. Description of original monument and accessories and/or subsequent restoration:

1. GENERAL LAND OFFICE: JOHN MULLETT, D.S. 1825, (R7W, P.5) BEECH 6 N40W .06 Do. 6 S37 1/2W 22

*** NO OTHER HISTORICAL INFORMATION, PUBLIC OR PRIVATE, AVAILABLE FOR THIS CORNER ***

B. Description of corner evidence found and/or method applied in restoring or reestablishing corner:

FOUND NO MAGNETIC EVIDENCE OF CORNER MONUMENTATION. TRAVERSED RANGE LINE 1/2 MILE NORTH TO M-5 AND 1/2 MILE SOUTH TO REESTABLISHED M-7, & TYING IN L-7 (T1N, R7W) INCLUDING OLD OCCUPATION FENCE LINE (WEST) AT M-6. COMPUTED POSITION ON RANGE LINE IN LINE WITH OLD OCCUPATION FENCE. EXCAVATION REVEALED A FEW SMALL PIECES OF COAL ON TOP OF CLAY GRADE (6" BELOW FINISHED GRADE) AT COMPUTED POSITION. CORNER POSITION LIES IN A SLIGHT CUT AREA (1'-2'). ACCEPTED FOUND COAL AT COMPUTED POSITION AS BEST AVAILABLE EVIDENCE OF CORNER POSITION.


SET STANDARD BARRY COUNTY REMONUMENTATION MONUMENT ON RANGE LINE IN LINE WITH OLD OCCUPATION FENCE LINE TO THE WEST.

C. Description of monument for corner and accessories established to perpetuate locating the position of the corner:

SET STANDARD BARRY COUNTY REMONUMENTATION MONUMENT (3/4" X 36" IRON) WITH ALUMINUM CAP. SET 20d NAIL W/PLASTIC TAG IN THE TOP CENTER OF A WOOD FENCE POST S36°W 51.03' SET 20d NAIL W/PLASTIC TAG IN THE TOP CENTER OF A WOOD CORNER FENCE POST WEST 30.04' SET 20d NAIL W/PLASTIC TAG IN THE WEST SIDE OF A 26" OAK S10°E 146.54' SET 1/2" x 18" IRON W/TRAVERSE POINT CAP N27°E 76.24' SET 1/2" x 18" IRON W/TRAVERSE POINT CAP S88°E 41.18' 1/2" x 18" IRON W/TRAVERSE POINT CAP (BL1-52-149-TP) S25°W 27.04' A-6, T1N, R6W, LIES NORTH 42.40' IN LINE WITH OLD FENCE WEST 2'+/- WEST OF NORTH-SOUTH GRAVEL CENTERLINE (CURTIS ROAD) 30'+/- SOUTH OF GRAVEL CENTERLINE EAST (LINK HIGHWAY)

ACT 345 BARRY COUNTY REMONUMENTATION APPROVED BY PEER REVIEW AT A MEETING HELD ON

14 July 97 BRIAN REYNOLDS COUNTY SURVEYOR

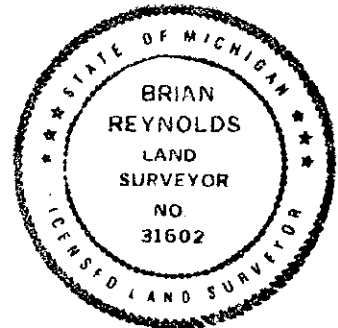

Signed by [Signature] Surveyor's Michigan License No 31602

Date APRIL 20, 1998