

SURVEY & REMONUMENTATION

AUG 22 1995

BARRY COUNTY REMONUMENTATION

STATE OF MICHIGAN COUNTY OF BARRY RECEIVED FOR RECORD

JAN 25 8 34 AM '95

COMMISSION

LAND CORNER RECORDATION CERTIFICATE Filing Requirement of Act 74, Mich. P.A. 1970

Sandy Schondelmarer REGISTER OF DEEDS

For corners in BARRY

Table with columns: Located In: (County), Corner Code #, and rows for Public Land Survey, Property Controlling, and Miscellaneous.

002281 Sequence # 2 Register of Deeds Stamp & File Number

4. Lot No. , Recorded Plat 5. Private Claims

BRIAN REYNOLDS

20 DECEMBER

1994

I, BRIAN REYNOLDS, in a field survey on 20 DECEMBER, 1994, do hereby certify that under requirements of P.A. 74, Michigan P.A. of 1970, the corner points mentioned in lines 1 and 2 above were in conformance with regulations and rules therefore as required in the current manual of survey instructions of the United States Department of the Interior, Bureau of Land Management or by a decree of a Court of Law and/or that the corner points mentioned in lines 3, 4 and 5 above were in conformance with the rules of the Michigan Board of Land Surveyors or by a Decree of a Court of Law: established, re-established, monumented, re-monumented, recovered, found as expressed below:

NOTE: Not more than 4 corners, all in the same town and range, may be recorded on this certificate.

Grid table with columns A-L and rows 2-13.

A. Description of original monument and accessories and/or subsequent restoration:

- 1 GENERAL LAND OFFICE: JOHN MULLET, D.S., 1825 (R7W, P.4) B. OAK 6 S20W 36 W. OAK 5 N73W 13
2 CONSUMERS POWER COMPANY: "FOUND PLOW POINT 2' BELOW FILL, SET "T" IRON OVER" EDGE OF ROAD N 11.0' EDGE OF ROAD S 9.0' TELE POLE N53W 53.4' 22" H. NUT S15W 36.4'
3 LAND CORNER RECORDATION CERTIFICATE: #2133, DANIEL M. RYAN, P.S. #34975, 7 DEC., 1993, "FOUND "T" IRON IN GRAVEL ROAD. BENT TOP OF "T" IRON OVER AND DOWN. SET 3/4" BARRY COUNTY REMONUMENTATION IRON AND CAP."
6" HICKORY S49°E 44.63 FEET. SET 60p NAIL IN NORTH SIDE.
14" HICKORY, S20°E, 45.82 FEET. FOUND NAIL & SPOTTER ON WEST SIDE.
18" OAK, S34°W, 43.36 FEET. FOUND NAIL & SPOTTER ON EAST SIDE.
10" OAK, N3°W, 34.82 FEET. FOUND NAIL & SPOTTER ON EAST SIDE.
1', MORE OR LESS, SOUTH OF CENTERLINE OF EAST/WEST ROAD.


B. Description of corner evidence found and/or method applied in restoring or reestablishing corner:

THIS CORNER WAS APPROVED FOR REMONUMENTATION IN 1993 AT THE POSITION INDICATED ON A CONSUMERS POWER SURVEY c.1965. BASED ON RECENT MEASUREMENTS IN SECTIONS 30 AND 31 OF BELLEVUE TOWNSHIP, EATON COUNTY, THE POSITION REMONUMENTED IN LAND CORNER RECORDATION CERTIFICATE #2133 WAS FOUND TO BE THE CLOSING EATON COUNTY CORNER. A SUBSEQUENT EXCAVATION 19'+/- SOUTH OF THE CLOSING CORNER REVEALED A 1" X 48" GAS PIPE SURROUNDED BY STONES AND BRICK. ACCEPTED GAS PIPE AS THE PROPER PERPETUATION OF CORNER. REPLACED 1"X 48" GAS PIPE WITH STANDARD BARRY COUNTY REMONUMENTATION MONUMENT.

ACT 345 BARRY COUNTY REMONUMENTATION APPROVED BY PEER REVIEW AT A MEETING HELD ON 6 Dec '94 BRIAN REYNOLDS COUNTY SURVEYOR

C. Description of monument for corner and accessories established to perpetuate locating the position of the corner:

SET STANDARD BARRY COUNTY REMONUMENTATION MONUMENT (3/4"X36"W/ALUMINUM CAP) FOUND NAIL WITH SHINER ON THE SOUTHEAST SIDE OF A 20" OAK S50°W 28.37' FOUND NAIL WITH BOTTLE CAP ON THE SOUTHWEST SIDE OF A 14" HICKORY S30°E 29.11' FOUND NAIL WITH BOTTLE CAP ON THE EAST SIDE OF A 10" OAK N5°W 53.76' A-11 TOWN 1 NORTH, RANGE 6 WEST, 3/4" REMONUMENTATION IRON NORTH 19.06' 19' SOUTH OF THE CENTERLINE OF JONES ROAD (GRAVEL) ON CENTERLINE OF TRAIL ROAD SOUTH

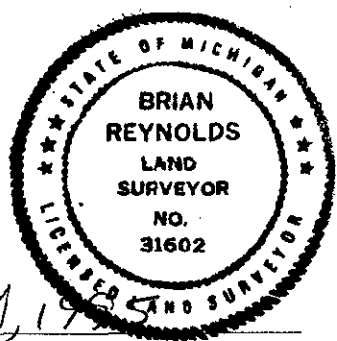

Signed by [Signature]

Date JANUARY 21, 1995

Surveyor's Michigan License No. 31602