

FEB 03 1999

For Corners in SECTION Located In: Corner Code #
BARRY
(county)

1. Public Land Survey T 1N R 8W C-11
CORNER COMMON TO T _____ R _____
SECTIONS 29, 30, 31 & 32 T _____ R _____
JOHNSTOWN TOWNSHIP T _____ R _____



2753
Page: 1 of 1
12/17/1998 12:35P

2. Property Controlling in Section S _____ T _____ R _____
S _____ T _____ R _____

Register of Deeds Stamp & File Number

3. Miscellaneous Property in Sec. S _____ T _____ R _____
S _____ T _____ R _____

4. Lot No _____, Recorded Plat _____

5. Private Claims _____

I, **Brian Reynolds**, in a field survey on 5 Feb. 98 do hereby certify that under requirements of P.A. 74, Michigan P.A. of 1970, the corner points mentioned in lines 1 and 2 above were in conformance with regulations and rules therefore as required in the current manual of survey instructions of the United States Department of the Interior, Bureau of Land Management or by a decree of a Court of Law and/or that the corner points mentioned in lines 3, 4, and 5 above were in conformance with the rules of the Michigan Board of Land Surveyors or by a Decree of a Court of Law; established, re-established, monumented, re-monumented, recovered, found as expressed below.

	A	B	C	D	E	F	G	H	I	J	K	L	M
1													
2	6	5	4	3	2	1							
3													
4	7	8	9	10	11	12							
5													
6	18	17	16	15	14	13							
7													
8	19	20	21	22	23	24							
9													
10	30	29	28	27	26	25							
11													
12	31	32	33	34	35	36							
13													

NOTE: Not more than 2 corners, all in the same town and range, may be recorded on this certificate.

A. Description of original monument and accessories and/or subsequent restoration:


- GENERAL LAND OFFICE: MUSGROVE EVANS, D.S., 1826 (R8W, P.32) W. O. 18 N26E 30 Do. 24 S76E 20
- PRIVATE NOTES: FROM THE DEKEYSER FILES (JAMES L. KING, P.S. #14766) APRIL 1965; "SET 1/4" IRON AS PER OCCUPATION & OLD GOVT. DISTANCE FROM EDGE OF 2 SWAMPS" 12" W. OAK N65°E 25.30' 18" W. OAK N30°W 31.95' 6" MAPLE S65°E 15.00' 6" OAK N85°W 35.22' "PT IS IN CENTER OF OLD RD. BED & ON LINE WITH FNC. E & W"
- CONSUMERS POWER SURVEY: c. 1965, RECITE SAME WITNESSES AS IN #2 ABOVE
- UNRECORDED SURVEY: BY DON DAVIS, P.S. #17617, AUG 1980 (JOB #8093) "SOUTHWEST CORNER SECTION 29... 1/4" PIPE" 12" OAK N65°E 25.30' 18" OAK N30°W 31.95' 6" OAK N85°W 35.22'

*** NO OTHER HISTORICAL DATA, PUBLIC OR PRIVATE, AVAILABLE FOR THIS CORNER ***

B. Description of corner evidence found and/or method applied in restoring or reestablishing corner:
FOUND 1/4" PIPE WITH ONE OLD RED BRICK ON TOP. ALSO FOUND WITNESSES W. OAK N30°W & W. OAK N65°E & STUMP OF MAPLE S65°E FROM ITEMS 2, 3 & 4 ABOVE. OCCUPATION EAST-WEST IN FORM OF OLD DECAYING FENCES. ACCEPTED FOUND PIPE AS BEST AVAILABLE EVIDENCE OF CORNER POSITION. REPLACED FOUND PIPE WITH STANDARD BARRY COUNTY REMONUMENTATION MONUMENT.

C. Description of monument for corner and accessories established to perpetuate locating the position of the corner:
SET STANDARD BARRY COUNTY REMONUMENTATION MONUMENT (3/4" X 36" IRON) WITH ALUMINUM CAP.
FOUND NAIL IN THE NORTHEAST SIDE OF A 30" OAK N36°W 31.81'
FOUND NAIL IN THE SOUTH SIDE OF AN 18' OAK N52°E 25.30'
SET 20d NAIL W/PLASTIC TAG IN THE SOUTH SIDE OF A 14" OAK N77°W 14.85'
SET 20d NAIL W/PLASTIC TAG IN THE NORTH SIDE OF A 48" OAK N76°E 13.21'
SET 20d NAIL W/PLASTIC TAG IN THE WEST SIDE OF A 10" OAK S06°W 34.46'
ROUGHLY ON CENTERLINE OF ABANDONED ROADWAY NORTH-SOUTH
ROUGHLY IN LINE WITH DECAYING FENCE LINES EAST-WEST

ACT 345 BARRY COUNTY REMONUMENTATION
APPROVED BY PEER REVIEW AT A MEETING HELD ON
9 Feb. '98
BRIAN REYNOLDS COUNTY SURVEYOR

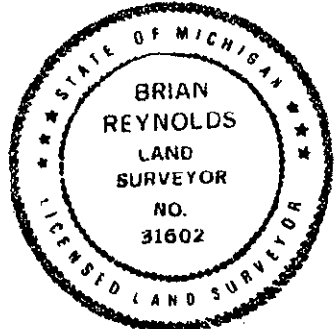

Signed by [Signature]
Surveyor's Michigan License No. 31602

Date DEC 15, 1998