

DEC 7 4 26 PM '93

Sandy Schendelmaier
REGISTER OF DEEDS

BARRY COUNTY REMONUMENTATION
LAND CORNER RECORDATION CERTIFICATE
Filing Requirement of Act 74, Mich. P.A. 1970

002138

Register of Deeds Stamp & File Number

corners in
Barry
(County)

Located In:	Corner Code #
T <u>1N</u> R <u>8W</u>	<u>C-12</u>
T _____ R _____	_____
T _____ R _____	_____
T _____ R _____	_____
T _____ R _____	_____
S _____ T _____ R _____	_____
S _____ T _____ R _____	_____
S _____ T _____ R _____	_____
S _____ T _____ R _____	_____

Public Land Survey

Property Controlling
in Section
Miscellaneous
Property in Sec.

Lot No. _____, Recorded Plat _____
Private Claims _____

	A	B	C	D	E	F	G	H	I	J	K	L	M
2	6	5	4	3	2	1							
3													
4	7	8	9	10	11	12							
5													
6	18	17	16	15	14	13							
7													
8	19	20	21	22	23	24							
9													
10	30	29	28	27	26	25							
11													
12	31	32	33	34	35	36							
13													

Daniel M. Ryan, in a field survey on September 8, 19 93,
hereby certify that under requirements of P.A. 74, Michigan P.A. of 1970, the corner points mentioned
lines 1 and 2 above were in conformance with regulations and rules therefore as required in the
current manual of survey instructions of the United States Department of the Interior, Bureau of Land
Management or by a decree of a Court of Law and/or that the corner points mentioned in lines 3, 4 and 5
above were in conformance with the rules of the Michigan Board of Land Surveyors or by a Decree of a
Court of Law; established, re-established, monumented, re-monumented, recovered, found as
expressed below:

**NOTE: Not more than 4 corners, all in the same town and range, may be recorded
on this certificate.**

Description of original monument and accessories and/or subsequent restoration:
GLO: 18" White Oak, S55 1/2°W, 23 links
18" Black Oak, N53°W, 58 links

C.P.Co.: Found drag shoe
Set 1/2 bar beside
in centerline of rods
U-pole, N25°E, 60.60 feet
8" Hickory, S20°W, 74.32 feet
NW corner house found, S45°E, 89.35
feet


County Road Commission: Iron stake
Sign post, N45°E, 34.6 feet
36" Elm stump, S45°W, 36 feet
18" Ash, S50°E, 41.6 feet

Description of corner evidence found and/or method applied in restoring or reestablishing corner:
Found drag shoe & R.R. spike.
Witness were to drag shoe
Northwest corner house found, S45°E, 89.35 feet
18" Hickory, S20°W, 74.34 feet

SURVEY &
REMONUMENTATION
APR 05 1994
COMMISSION

Description of monument for corner and accessories established to perpetuate locating the position of the corner:

Bent drag shoe and set 3/4" iron with aluminum remonumentation cap.
Northwest corner house found, S45°E, 89.35 feet
18" Hickory, S20°W, 74.34 feet, to nail on West side.
Railroad tie fence post, N40°E, 40.27 feet, set PK on East side.
8" Twin Hickory, S60°W, 45.20 feet, 60p nail on Northwest side.

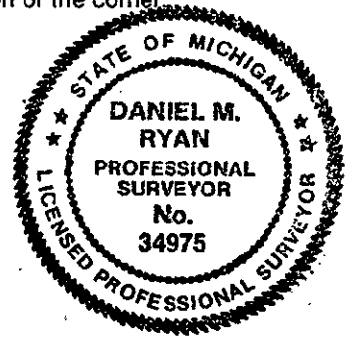

Surveyed by [Signature] Date September 8, 1993
Surveyor's Michigan License No. 34975