

SURVEY & REMONUMENTATION

BARRY COUNTY REMONUMENTATION

STATE OF MICHIGAN
COUNTY OF BARRY
RECEIVED FOR RECORD

NOV 04 1996

LAND CORNER RECORDATION CERTIFICATE
Filing Requirement of Act 74, Mich. P.A. 1970

SEP 27 10 48 AM '96

For corners in **COMMISSION**

Sandy Schondelmar
REGISTER OF DEEDS

| BARRY (County) | Located In: | Corner Code # |
|------------------------------------|-------------------------|---------------|
| JOHNSTOWN TWP. | | |
| 1. Public Land Survey | T <u>1 N R 8 W</u> | <u>E-7</u> |
| | T _____ R _____ | _____ |
| | T _____ R _____ | _____ |
| | T _____ R _____ | _____ |
| 2. Property Controlling in Section | S _____ T _____ R _____ | _____ |
| | S _____ T _____ R _____ | _____ |
| 3. Miscellaneous Property in Sec. | S _____ T _____ R _____ | _____ |
| | S _____ T _____ R _____ | _____ |

002403

Register of Deeds Stamp & File Number

4. Lot No. _____, Recorded Plat _____
5. Private Claims _____

| | A | B | C | D | E | F | G | H | I | J | K | L | M |
|----|----|----|----|----|----|----|---|---|---|---|---|---|---|
| 2 | 6 | 5 | 4 | 3 | 2 | 1 | | | | | | | |
| 3 | | | | | | | | | | | | | |
| 4 | 7 | 8 | 9 | 10 | 11 | 12 | | | | | | | |
| 5 | | | | | | | | | | | | | |
| 6 | 18 | 17 | 16 | 15 | 14 | 13 | | | | | | | |
| 7 | | | | | | | | | | | | | |
| 8 | 19 | 20 | 21 | 22 | 23 | 24 | | | | | | | |
| 9 | | | | | | | | | | | | | |
| 10 | 30 | 29 | 28 | 27 | 26 | 25 | | | | | | | |
| 11 | | | | | | | | | | | | | |
| 12 | 31 | 32 | 33 | 34 | 35 | 36 | | | | | | | |
| 13 | | | | | | | | | | | | | |

I, ROBERT R. CARR, in a field survey on DECEMBER 6, 1995, do hereby certify that under requirements of P.A. 74, Michigan P.A. of 1970, the corner points mentioned in lines 1 and 2 above were in conformance with regulations and rules therefore as required in the current manual of survey instructions of the United States Department of the Interior, Bureau of Land Management or by a decree of a Court of Law and/or that the corner points mentioned in lines 3, 4 and 5 above were in conformance with the rules of the Michigan Board of Land Surveyors or by a Decree of a Court of Law; established, re-established, monumented, re-monumented, recovered, found as expressed below:

NOTE: Not more than 4 corners, all in the same town and range, may be recorded on this certificate.

A. Description of original monument and accessories and/or subsequent restoration:

G.L.O. MUSGROVE EVANS 1826.
CO. SURVEYOR BOWEN, 1877, STONE, IRON & BRICK.
LCRC NO. 167, JAMES L.KING PS#14766, RECORDED JULY 17, 1975.
LCRC NO. 438, ROBERT R. CARR, PS#20704, RECORDED JULY 23, 1991.


B. Description of corner evidence found and/or method applied in restoring or reestablishing corner:

LCRC NO. 167 REPORTS IRON PIPE AND PREVIOUS WITNESSES (SOURCE NOT INDICATED), IRON PIPE WAS REMOVED BY ROAD CONSTRUCTION BUT WITNESSES REMAINED, AND A 1/2" IRON WAS SET FROM REMAINING WITNESSES.
LCRC NO. 438, RECOVERED 1/2" IRON PER LCRC NO. 167.
FOUND AND ACCEPTED 1/2" IRON PER LCRC NO. 438 AS BEST REMAINING EVIDENCE OF CORNER.

ACT 345 BARRY COUNTY REMONUMENTATION
APPROVED BY PEER REVIEW AT A MEETING HELD ON
11 March '96
BRIAN REYNOLDS COUNTY SURVEYOR

C. Description of monument for corner and accessories established to perpetuate locating the position of the corner:

REPLACED 1/2" IRON WITH BARRY COUNTY REMON STAKE & CAP.
NAIL & SPOTTER IN SOUTHEASTERLY SIDE OF 18" OAK N48°E 47.91 FEET.
NAIL & SPOTTER IN NORTHWESTERLY SIDE OF TWIN 10" HICKORY S70°W 63.76 FEET
NAIL & SPOTTER IN WEST SIDE OF 30" MAPLE S02°W 29.46 FEET
NAIL & SPOTTER IN EASTERLY SIDE OF 14" OAK N15°E 48.52 FEET.
NAIL & SPOTTER IN SOUTHWESTLY SIDE OF 36" MAPLE S39°E 40.72 FEET
8± FEET SOUTH OF CENTERLINE OF ROAD AND 2± FEET EAST OF FENCE TO SOUTH

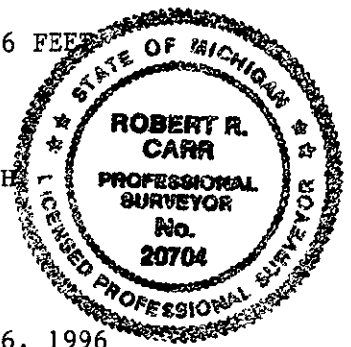

Signed by Robert R. Carr
Surveyor's Michigan License No. 20704

Date SEPTEMBER 6, 1996