

SURVEY & REMONUMENTATION

NOV 04 1996

**BARRY COUNTY REMONUMENTATION
LAND CORNER RECORDATION CERTIFICATE
Filing Requirement of Act 74, Mich. P.A. 1970**

STATE OF MICHIGAN
COUNTY OF BARRY
RECEIVED FOR RECORD

SEP 27 10 48 AM '96

Sandy Schondelmayer
REGISTER OF DEEDS

For corners in **COMMISSION**

<u>BARRY</u> (County) <u>JOHNSTOWN TWP.</u>	Located In:	Corner Code #
1. Public Land Survey	T <u>1 N R 8 W</u>	<u>F-7</u>
	T _____ R _____	_____
	T _____ R _____	_____
	T _____ R _____	_____
2. Property Controlling in Section	S _____ T _____ R _____	_____
	S _____ T _____ R _____	_____
3. Miscellaneous Property in Sec.	S _____ T _____ R _____	_____
	S _____ T _____ R _____	_____

002405

Register of Deeds Stamp & File Number

4. Lot No. _____, Recorded Plat _____
5. Private Claims _____

A	B	C	D	E	F	G	H	I	J	K
2	6	5	4	3	2					
3										
4	7	8	9	10	11					
5										
6	18	17	16	15	14					
7										
8	19	20	21	22	23					
9										
10	30	29	28	27	26					
11										
12	31	32	33	34	35					
13										

I, ROBERT R. CARR, in a field survey on DECEMBER 6, 19 95, do hereby certify that under requirements of P.A. 74, Michigan P.A. of 1970, the corner points mentioned in lines 1 and 2 above were in conformance with regulations and rules therefore as required in the current manual of survey instructions of the United States Department of the Interior, Bureau of Land Management or by a decree of a Court of Law and/or that the corner points mentioned in lines 3, 4 and 5 above were in conformance with the rules of the Michigan Board of Land Surveyors or by a Decree of a Court of Law; established, re-established, monumented, re-monumented, recovered, found as expressed below:

NOTE: Not more than 4 corners, all in the same town and range, may be recorded on this certificate.


A. Description of original monument and accessories and/or subsequent restoration:
G.L.O. MUSGROVE EVANS, 1826.
PRATT, 1881, FOUND BEARINGS AND SET POST.
LCRC NO. 438, ROBERT R. CARR, PS#20704, RECORDED JULY 23, 1991.

B. Description of corner evidence found and/or method applied in restoring or reestablishing corner:
FOUND 3/4" IRON PIPE IN MARSH FROM WITNESSES OF LCRC NO. 438.
REMAINS OF FENCE RUNNING TO WEST.
NO OTHER EVIDENCE BEING FOUND, ACCEPTED 3/4" IRON PIPE AS TRUE PERPETUATION OF CORNER.

ACT 345 BARRY COUNTY REMONUMENTATION
APPROVED BY PEER REVIEW AT A MEETING HELD ON

11 March '96
BRIAN REYNOLDS COUNTY SURVEYOR

C. Description of monument for corner and accessories established to perpetuate locating the position of the corner:
PLACED BARRY COUNTY REMON STAKE AND CAP ON SOUTH SIDE OF IRON PIPE.
NAIL & SPOTTER IN SOUTHEASTERLY SIDE OF 12" MAPLE N73°E 53.87 FEET.
NAIL & SPOTTER IN SOUTHEASTERLY SIDE OF 6" ASH N64°E 73.72 FEET.
NAIL & SPOTTER IN SOUTHEASTERLY SIDE OF 4" ELM N45°E 46.46 FEET.
NAIL & SPOTTER IN NORTHEASTERLY SIDE OF 4" ELM N38°W 41.39 FEET.
2646.63 FEET EAST OF SOUTHWEST CORNER OF SECTION 16.
2736.82 FEET SOUTH OF HISTORIC CENTER OF SECTION 16.

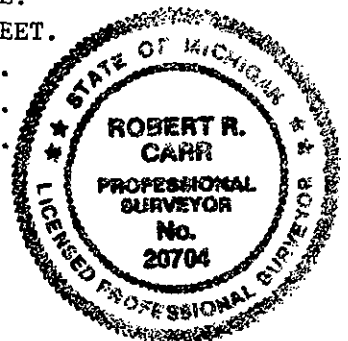

Signed by [Signature]
Surveyor's Michigan License No. 20704

Date SEPTEMBER 6, 1996