

**SURVEY & REMONUMENTATION**

**FEB 17 1998**

**SECTION**

**BARRY COUNTY REMONUMENTATION  
LAND CORNER RECORDATION CERTIFICATE  
Filing Requirement of Act 74, Mich. P.A. 1970**

For corners in

BARRY  
(County)

Located In:

Co



**2653**

Page: 1 of 1  
12/16/1997 12:20P

Johnstown Township, Section 23

Sandy Schondelmayer - Barry Co. LCRCR

- |                                    |                         |            |
|------------------------------------|-------------------------|------------|
| 1. Public Land Survey              | T <u>1N</u> R <u>8W</u> | <u>1-8</u> |
|                                    | T _____ R _____         | _____      |
|                                    | T _____ R _____         | _____      |
|                                    | T _____ R _____         | _____      |
| 2. Property Controlling in Section | S _____ T _____ R _____ | _____      |
|                                    | S _____ T _____ R _____ | _____      |
| 3. Miscellaneous Property in Sec.  | S _____ T _____ R _____ | _____      |
|                                    | S _____ T _____ R _____ | _____      |

Register of Deeds Stamp & File Number

4. Lot No. \_\_\_\_\_, Recorded Plat \_\_\_\_\_
5. Private Claims \_\_\_\_\_

I, Robert R. Carr, in a field survey on May 23, 1997 do hereby state that under requirements of P.A. 74, Michigan P.A. of 1970, the corner points mentioned in lines 1 and 2 above were in conformance with regulations and rules therefore as required in the current manual of survey instructions of the United States Department of the Interior, Bureau of Land Management or by a decree of a Court of Law and /or that the corner points mentioned in lines 3, 4 and 5 above were in conformance with the rules of the Michigan Board of Land Surveyors or by a Decree of a Court of Law; established, re-established, monumented, recovered, found as expressed below:

**NOTE: Not more than 2 corners, all in the same town and range, may be recorded on this certificate.**

	A	B	C	D	E	F	G	H	I	J	K	L	M
1													
2		6		5		4		3		2			1
3													
4		7		8		9		10		11			12
5													
6		18		17		16		15		14			13
7													
8		19		20		21		22	●	23			24
9													
10		30		29		28		27		26			25
11													
12		31		32		33		34		35			36
13													

**A. Description of original monument and accessories and/or subsequent restoration:**

- G.L.O., MUSGROVE EVANS, D.S. 1826
- BARRY COUNTY SURVEYOR RECORDS, FOUND STONES AND BRICK SET BY FORMER SURVEYOR, NO DATE OR NAME.
- L.C.R.C. FILE NO. 237 BY ROBERT R. CARR, 1976
- C.F. CHAMBERS, 1964, IRON STAKE

**B. Description of corner evidence found and/or method applied in restoring or reestablishing corner:**

- NO EVIDENCE OF G/L/O/ BEARINGS
- NO STONE OR BRICK FOUND, AREA IS IN ROAD CUT 4' MORE OR LESS
- FOUND 5/8" IRON WITH CONCRETE MONUMENT WEST 33.0' PER L.C.R.C. FILE NO. 237.
- 5/8" IRON PER L.C.R.C. FILE NO. 237 IS PERPETUATION OF IRON STAKE USED BY C.F. CHAMBERS IN 1964, CHAMBERS BEARINGS STILL STANDING.

ACT 345 BARRY COUNTY REMONUMENTATION  
APPROVED BY PEER REVIEW AT A MEETING HELD 1


8 July '96  
BRIAN REYNOLDS

JSR  
COUNTY SURVEYOR

**C. Description of monument for corner and accessories established to perpetuate locating the position of the corner:**

ACCEPTED FOUND 5/8" IRON AS BEST EVIDENCE OF CORNER AND PLACED BARRY COUNTY REMONUMENTATION STAKE AND CAP IN MONUMENT BOX, FROM WHICH BEARS;

- 30" OAK, N88degE 24.40' SET SPOTTER
- 14" OAK, S72degW 35.41' SET SPOTTER
- 14" SOUR CHERRY, N65degW 36.81' SET SPOTTER
- TWIN 12" & 8" OAK, N34degE 45.31' SET SPOTTER
- 4' MORE OR LESS EAST OF CENTERLINE OF ROAD NORTH AND SOUTH CONCRETE MONUMENT, WEST 33' MORE OR LESS
- 1/2" IRON STAKE, EAST 33'.

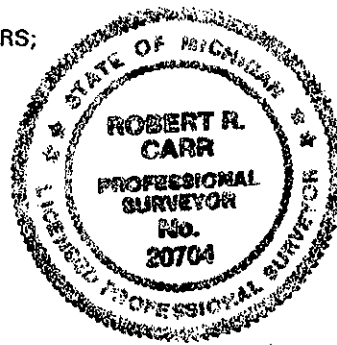

Signed by [Signature]  
Surveyor's Michigan License No. 20704

Date NOV. 10, 1997