

**SURVEY & REMONUMENTATION**

FEB 17 1998

**SECTION**

**BARRY COUNTY REMONUMENTATION  
LAND CORNER RECORDATION CERTIFICATE  
Filing Requirement of Act 74, Mich. P.A. 1970**

For corners in

BARRY  
(County)

Located In:



**2654**  
Page: 1 of 1  
12/16/1997 12:20P

Sandy Schondelmayer - Barry Co. LCRCR

JOHNSTOWN TOWNSHIP

1. Public Land Survey

T 1N R 8W 1-9

T \_\_\_\_\_ R \_\_\_\_\_

T \_\_\_\_\_ R \_\_\_\_\_

T \_\_\_\_\_ R \_\_\_\_\_

2. Property Controlling in Section

S \_\_\_\_\_ T \_\_\_\_\_ R \_\_\_\_\_

S \_\_\_\_\_ T \_\_\_\_\_ R \_\_\_\_\_

3. Miscellaneous Property in Sec.

S \_\_\_\_\_ T \_\_\_\_\_ R \_\_\_\_\_

S \_\_\_\_\_ T \_\_\_\_\_ R \_\_\_\_\_

Register of Deeds Stamp & File Number

4. Lot No. \_\_\_\_\_, Recorded Plat \_\_\_\_\_

5. Private Claims \_\_\_\_\_

I, ROBERT R. CARR, in a field survey on MAY 22, 1997 do hereby state that under requirements of P.A. 74, Michigan P.A. of 1970, the corner points mentioned in lines 1 and 2 above were in conformance with regulations and rules therefore as required in the current manual of survey instructions of the United States Department of the Interior, Bureau of Land Management or by a decree of a Court of Law and /or that the corner points mentioned in lines 3, 4 and 5 above were in conformance with the rules of the Michigan Board of Land Surveyors or by a Decree of a Court of Law; established, re-established, monumented, recovered, found as expressed below:

**NOTE: Not more than 2 corners, all in the same town and range, may be recorded on this certificate.**

A. Description of original monument and accessories and/or subsequent restoration:

1826 MUSGROVE EVANS D.S. B.O. 6 S84-1/2°W 32; W.O. 9 N62°E 82.  
1868 A.C. WILSON, FOUND BEARINGS  
1876 BOWEN, STONE BEARINGS FOUND,  
NO DATE, UNKNOWN SURVEYOR, FOUND STONE & BRICK BY FORMER SURVEYOR  
WITNESS CARD FROM RECORDS OF DEKEYSER AND ASSOCIATES, NO NAME OR DATE, FOR SOUTHEAST CORNER OF SECTION 23 APPEARS TO BE MIS-MARKED AND IS ACTUALLY FOR SOUTHWEST CORNER OF SECTION 23  
21" PINE S88°W 54 FEET; 2" MAPLE S20°E 56.5 FEET; 12" CHERRY S60°E 53.5 FEET.  
WITNESSES BY CARR FROM RECORDS OF DEKEYSER AND ASSOCIATES  
TELE. POLE N30°E 52.45 FEET; 36" PINE S80°W 56.63 FEET; 7" W. CHERRY N15°W 87 FEET; 1 FOOT EAST OF CENTERLINE OF PAVEMENT.

	A	B	C	D	E	F	G	H	I	J	K	L	M
1													
2	6		5		4		3		2		1		
3													
4	7		8		9		10		11		12		
5													
6	18		17		16		15		14		13		
7													
8	19		20		21		22		23		24		
9													
10	30		29		28		27		26		25		
11													
12	31		32		33		34		35		36		
13													

B. Description of corner evidence found and/or method applied in restoring or reestablishing corner:

FOUND 1/2" IRON AT SURFACE OF BITUMINOUS ROAD MATCHING WITNESS TO 36" PINE BY CARR (DEKEYSER & ASSOCIATES DUG AND FOUND LARGE OBLONG STONE ON END WITH PLOW POINT ON WEST SIDE ABOUT 2 FEET DEEP AND 2.2 FEET SOUTHWESTERLY OF 1/2" IRON. With 36" PINE S87°W 55 FEET MORE OR LESS TO CENTER.  
ACCEPTED STONE AS BEST EVIDENCE OF ORIGINAL CORNER AND SET BARRY COUNTY REMONUMENTATION STAKE AND CAP OVER STONE IN MONUMENT BOX.


ACT 345 BARRY COUNTY REMONUMENTATION  
APPROVED BY PEER REVIEW AT A MEETING HELD ON

14 July '97  
BRIAN REYNOLDS

BR  
COUNTY SURVEYOR

C. Description of monument for corner and accessories established to perpetuate locating the position of the corner:

BARRY COUNTY REMONUMENTATION STAKE AND CAP IN MONUMENT BOX  
SET SPOTTER IN 36" PINE, S87°W 55.05 FEET; SET SPOTTER IN 30" LOCUST, N10°W 88.76 FEET;  
SET SPOTTER IN UTILITY POLE, S23°E 87.90 FEET; NORTHEAST CORNER OF HOUSE 109.70 FEET TO SIDING;  
1/2" IRON NORTHEASTERLY 2.18 FEET.

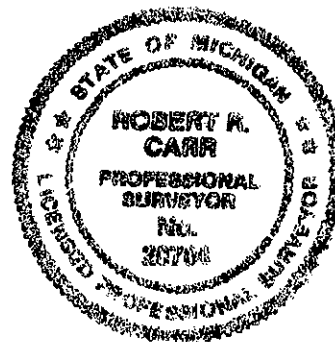

Signed by [Signature]  
Surveyor's Michigan License No. 20704

Date NOV 10, 1997