

**SURVEY & REMONUMENTATION**

**FEB 17 1998**

**SECTION**

**BARRY COUNTY REMONUMENTATION  
LAND CORNER RECORDATION CERTIFICATE  
Filing Requirement of Act 74, Mich. P.A. 1970**

For corners in

BARRY  
(County)

Located In:



**2657**  
Page: 1 of 1  
12/16/1997 12:20P

Sandy Schondelmayer - Barry Co. LCRCR

- 1. Public Land Survey T 1N R 8W J-9
- 2. Property Controlling in Section S T R
- 3. Miscellaneous Property in Sec. S T R
- 4. Lot No. \_\_\_\_\_, Recorded Plat \_\_\_\_\_
- 5. Private Claims \_\_\_\_\_

Register of Deeds Stamp & File Number

I, ROBERT R. CARR, in a field survey on APRIL 22, 19 97 do hereby state that under requirements of P.A. 74, Michigan P.A. of 1970, the corner points mentioned in lines 1 and 2 above were in conformance with regulations and rules therefore as required in the current manual of survey instructions of the United States Department of the Interior, Bureau of Land Management or by a decree of a Court of Law and /or that the corner points mentioned in lines 3, 4 and 5 above were in conformance with the rules of the Michigan Board of Land Surveyors or by a Decree of a Court of Law; established, re-established, monumented, recovered, found as expressed below:

**NOTE: Not more than 2 corners, all in the same town and range, may be recorded on this certificate.**

**A. Description of original monument and accessories and/or subsequent restoration:**

- 1826 MUSGROVE EVANS D.S. W.O. 5" S21°E 56 LKS; W.O. 18" N68°W 69LKS.
- 1868 A.C. WILLSON FOUND BEARINGS, SET STAKE STONE AND BRICKS.
- 1876 BOWEN, STONE AND BRICK.

	A	B	C	D	E	F	G	H	I	J	K	L	M
1													
2		6		5		4		3		2		1	
3													
4		7		8		9		10		11		12	
5													
6		18		17		16		15		14		13	
7													
8		19		20		21		22		23		24	
9										●			
10		30		29		28		27		26		25	
11													
12		31		32		33		34		35		36	
13													


**B. Description of corner evidence found and/or method applied in restoring or reestablishing corner:**

CORNER IS IN CUT SECTION (2'-5' DEEP) AT INTERSECTION OF ROADS.  
FOUND LARGE SPIKE AT INTERSECTION OF CENTERLINES OF ROADS  
DUG FOR STONE AND BRICK BUT FOUND NOTHING.  
ACCEPTED SPIKE AT INTERSECTION OF CENTERLINES OF ROADS AS BEST EVIDENCE OF CORNER  
AND SET BARRY COUNTY REMONUMENTATION STAKE AND CAP IN MONUMENT BOX.

ACT 345 BARRY COUNTY REMONUMENTATION  
APPROVED BY PEER REVIEW AT A MEETING HELD ON  
8 July, 98 ISR  
BRIAN REYNOLDS COUNTY SURVEYOR

**C. Description of monument for corner and accessories established to perpetuate locating the position of the corner:**

- BARRY COUNTY REMONUMENTATION STAKE AND CAP IN MONUMENT BOX.
- SET SPOTTER IN 40" MAPLE, N16°W 118.28 FEET;
- SET SPOTTER IN UTILITY POLE, S50°W 52.37 FEET
- SOUTHEAST CORNER OF HOUSE FOUNDATION (ENCLOSED PORCH), N50°W 90.62 FEET
- NORTHEAST CPRNER OF HOUSE FOUNDATION, S60°E 151.07 FEET
- 14" MAPLE, N70°E 144.26 FEET.

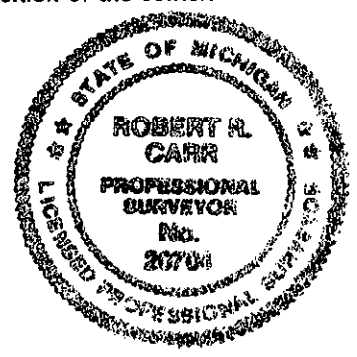

Signed by [Signature]  
Surveyor's Michigan License No. 20704

Date Nov 10, 1997