BARRY COUNTY REMONUMENTATION

LAND CORNER RECORDATION CERTIFICATE
Filing Requirement of Act 74, Mich. P.A. 1970

SURVEY & REMONUMENTATION
APR 0 4 2000
SECTION

For Corners in BARRY (county)	Located In:	Corner Code #
1. Public Land Survey	T 1N R 8W	J-10
CENTER 1/4 CORNER	T___ R___	
SECTION 26	T___ R___	
JOHNSTOWN TOWNSHIP	T___ R___	
2. Property Controlling in Section	S___ T___ R___	
	S___ T___ R___	
3. Miscellaneous	S___ T___ R___	

2849
Page: 1 of 1
12/27/1999 01:44P
Darla K. Burghdoff- Barry Co. LCRCR
Register of Deeds Stamp & File Number

4. Lot No_____, Recorded Plat_____
5. Private Claims_____

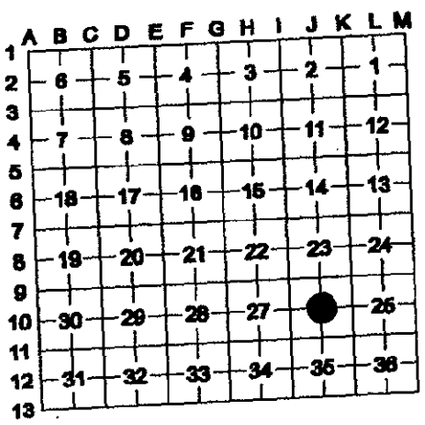

I, Brian Reynolds, in a field survey on 25 MARCH, 1999 do hereby certify that under requirements of P.A. 74, Michigan P.A. of 1970, the corner points mentioned in lines 1 and 2 above were in conformance with regulations and rules therefore as required in the current manual of survey instructions of the United States Department of the Interior, Bureau of Land Management or by a decree of a Court of Law and/or that the corner points mentioned in lines 3, 4, and 5 above were in conformance with the rules of the Michigan Board of Land Surveyors or by a Decree of a Court of Law; established, re-established, monumented, re-monumented, recovered, found as expressed below.
NOTE: Not more than 2 corners, all in the same town and range, may be recorded on this certificate.

A. Description of original monument and accessories and/or subsequent restoration:
1. THIS CORNER WAS NOT SET BY THE GENERAL LAND OFFICE
2. COUNTY SURVEYOR RECORDS: A. C. WILLSON, JANUARY 1868 (L.2, P.204) "SET POST-STAKE STONE FOR CORNER"
3. COUNTY SURVEYOR RECORDS: A. C. WILLSON, 01-29-1876 (L.1, P.135) "STONE FOR CORNER" NO WITNESSES

B. Description of corner evidence found and/or method applied in restoring or reestablishing corner:

APPARENT CORNER LOCATION LIES OFF THE EDGE OF A GRAVEL ROAD CURVE, WITH ROAD NORTH AND EAST, IN LINE WITH FENCE SOUTH. FOUND NO MAGNETIC EVIDENCE OF CORNER MONUMENT. EXCAVATED AT APPARENT CORNER LOCATION, FOUND NOTHING. TRAVERSED ENTIRE SECTION 26, TYING IN OCCUPATION AND EXTERIOR CORNERS. COMPUTED CORNER LOCATION AT INTERSECTION OF 1/4 LINES (WHICH IS CONSISTENT WITH OCCUPATION), RETURNED AND EXCAVATED FURTHER AN AREA ABOUT 12' SQUARE TO A DEPTH OF ABOUT 3 FEET, THEN PROBED ANOTHER 3 FEET, CENTERED ON COMPUTED CORNER LOCATION, FOUND NOTHING. SET STANDARD BARRY COUNTY REMONUMENTATION MONUMENT (3/4" X 36" IRON) WITH ALUMINUM CAP FOR SUBJECT CORNER AT INTERSECTION OF 1/4 LINES.

C. Description of monument for corner and accessories established to perpetuate locating the position of the corner:
SET STANDARD BARRY COUNTY REMONUMENTATION MONUMENT (3/4" X 36" IRON) WITH ALUMINUM CAP.
SET 20d NAIL W/PLASTIC TAG IN THE SOUTH SIDE OF A 14" WALNUT S73°W 60.08'
SET 20d NAIL W/PLASTIC TAG IN THE NORTH SIDE OF AN 8" ELM S63°E 30.29'
SET 20d NAIL W/PLASTIC TAG IN THE EAST SIDE OF A 22" OAK NORTH 131.11'
CHISELED "X" IN SOUTHWEST END CMP N70°E 22.52'
TOP CENTER OF A TELEPHONE RISER N79°E 100.52'
CORNER LIES 5'± SOUTH OF CENTERLINE OF ROAD EXTENDED FROM THE EAST
CORNER LIES 2'± EAST OF CENTERLINE OF ROAD EXTENDED FROM THE NORTH
CORNER IS IN LINE WITH FENCE TO THE SOUTH

ACT 345 BARRY COUNTY REMONUMENTATION
APPROVED BY PEER REVIEW AT A MEETING HELD ON
10 May, 99 BR
BRIAN REYNOLDS COUNTY SURVEYOR

STATE OF MICHIGAN
BRIAN REYNOLDS
LAND SURVEYOR
NO. 31602
LICENSED LAND SURVEYOR

Signed by [signature]
Surveyor's Michigan License No 31602

Date DEC 27, 1999

FORM APPROVED BY MICHIGAN STATE BOARD OF LAND SURVEYORS, JAN. 26, 1971
REVISED MAY 14, 1975 REVISED JANUARY, 1983 REVISED OCTOBER 1995