

**SURVEY & REMONUMENTATION**

FEB 17 1998

**SECTION**

**BARRY COUNTY REMONUMENTATION  
LAND CORNER RECORDATION CERTIFICATE  
Filing Requirement of Act 74, Mich. P.A. 1970**

For corners in

BARRY  
(County)  
JOHNSTOWN TOWNSHIP

Located In:

Corr



**2649**  
Page: 1 of 1  
12/16/1997 12:20P

Sandy Schondelmayer - Barry Co. LCRCR

- 1. Public Land Survey      T 1N R 8W      K-7
- T    R
- T    R
- T    R
- 2. Property Controlling    S    T    R
- in Section                S    T    R
- 3. Miscellaneous            S    T    R
- Property in Sec.         S    T    R

Register of Deeds Stamp & File Number

- 4. Lot No. \_\_\_\_\_, Recorded Plat \_\_\_\_\_
- 5. Private Claims \_\_\_\_\_

I, ROBERT R. CARR, in a field survey on MAY 22, 19 97 do hereby state that under requirements of P.A. 74, Michigan P.A. of 1970, the corner points mentioned in lines 1 and 2 above were in conformance with regulations and rules therefore as required in the current manual of survey instructions of the United States Department of the Interior, Bureau of Land Management or by a decree of a Court of Law and /or that the corner points mentioned in lines 3, 4 and 5 above were in conformance with the rules of the Michigan Board of Land Surveyors or by a Decree of a Court of Law; established, re-established, monumented, recovered, found as expressed below:

**NOTE: Not more than 2 corners, all in the same town and range, may be recorded on this certificate.**

	A	B	C	D	E	F	G	H	I	J	K	L	M
1													
2		6		5		4		3		2			1
3													
4		7		8		9		10		11			12
5													
6		18		17		16		15		14			13
7													
8		19		20		21		22		23			24
9													
10		30		29		28		27		26			25
11													
12		31		32		33		34		35			36
13													

**A. Description of original monument and accessories and/or subsequent restoration:**

1826 MUSGROVE EVANS D.S.  
W.O. 14 S84°E 3.50  
DO 12 S19°W 3.22

**B. Description of corner evidence found and/or method applied in restoring or reestablishing corner:**

FOUND BUGGY AXLE 2.5 FEET M/L EAST OF OLD FENCE CORNER IN SWAMP WITH FENCE RUNNING EAST AND SOUTH, VERY LARGE TREES IN FENCE TO EAST.

ACCEPTED BUGGY AXLE AS BEST EVIDENCE OF CORNER AND SET BARRY COUNTY REMONUMENTATION STAKE AND CAP.


ACT 345 BARRY COUNTY REMONUMENTATION  
APPROVED BY PEER REVIEW AT A MEETING HELD ON

8 July, '96  
BRIAN REYNOLDS

BR  
COUNTY SURVEYOR

**C. Description of monument for corner and accessories established to perpetuate locating the position of the corner:**

BARRY COUNTY REMONUMENTATION STAKE AND CAP  
SET SPOTTER IN 10" ELM, S43°E 55.52 FEET;  
SET SPOTTER IN 8" ELM, S37°E 50.30 FEET;  
SET SPOTTER IN 8" ELM, S05°E 63.75 FEET;  
0.5 FEET NORTH OF FENCE POST;  
2.5 FEET EAST OF FENCE SOUTH;  
STEEL "T" FENCE POST, WEST 0.4 FEET.

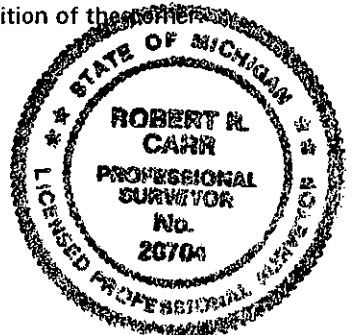

Signed by [Signature]  
Surveyor's Michigan License No. 20704

Date NOV 10, 1997