

**BARRY COUNTY REMONUMENTATION
LAND CORNER RECORDATION CERTIFICATE
Filing Requirement of Act 74, Mich. P.A. 1970**

STATE OF MICHIGAN
COUNTY OF BARRY
RECEIVED FOR RECORD

DEC 7 3 41 PM '93

Sandy Schondelmarjer
REGISTER OF DEEDS

For corners in

BARRY COUNTY
(County)
JOHNSTOWN TWP.

Located In: Corner Code #

1. Public Land Survey

T 1N R 8W F-3

2. Property Controlling in Section

S T R

3. Miscellaneous Property in Sec.

S T R

4. Lot No. Recorded Plat

5. Private Claims

002121

Sequence # 2

Register of Deeds Stamp & File Number

I, ROBERT R. CARR, in a field survey on SEPTEMBER 1, 19 93, do hereby certify that under requirements of P.A. 74, Michigan P.A. of 1970, the corner points mentioned in lines 1 and 2 above were in conformance with regulations and rules therefore as required in the current manual of survey instructions of the United States Department of the Interior, Bureau of Land Management or by a decree of a Court of Law and/or that the corner points mentioned in lines 3, 4 and 5 above were in conformance with the rules of the Michigan Board of Land Surveyors or by a Decree of a Court of Law; established, re-established, monumented, re-monumented, recovered, found as expressed below:

NOTE: Not more than 4 corners, all in the same town and range, may be recorded on this certificate.

	A	B	C	D	E	F	G	H	I	J	K	L	M
2	6	5	4	3	2	1							
3						⊕							
4	7	8	9	10	11	12							
5													
6	18	17	16	15	14	13							
7													
8	19	20	21	22	23	24							
9													
10	30	29	28	27	26	25							
11													
12	31	32	33	34	35	36							
13													

A. Description of original monument and accessories and/or subsequent restoration:

F-3 SETH PRATT, COUNTY SURVEYOR, MAY 4, 1885, SURVEY OF SECTION 4, LARGE STONE FOR CORNER, W 24", S52°E, 51 LKS;
M-DOT R/W MAP INDICATES CORNER IS S89°30'E, 55' FROM STATION 576+15.
M-DOT CONSTRUCTION PLANS CALL FOR LARGE STONE WITH CROCKERY AROUND.
R. CARR, P.S. # 20704 DUG FOR CORNER IN 1988 AT LOCATION INDICATED ON M-DOT PLANS, DID NOT FIND SET CONCRETE MONUMENT USING M-DOT DATA.
G.L.O. WHITE OAK 18" N20-1/2°W 54 LKS.; WHITE OAK 24" S52°E 51 LKS.

B. Description of corner evidence found and/or method applied in restoring or reestablishing corner:

F-3 FOUND CONCRETE MONUMENT AS ABOVE.
ALSO FOUND LARGE STONE ON SOUTHWEST SIDE OF FENCE CORNER POST 50'± EAST OF CENTERLINE M-37.
DUG AROUND STONE LOOKING FOR CROCKERY AND FOUND NONE.
ACCEPTED MONUMENT PREVIOUSLY SET AS CORNER.


SURVEY &
REMONUMENTATION

APR 05 1994

COMMISSION

C. Description of monument for corner and accessories established to perpetuate locating the position of the corner:

F-3 REPLACED CONCRETE MONUMENT WITH STANDARD BARRY COUNTY REMON, 3/4" STEEL ROD AND ALUMINUM CAP WITH CENTER PUNCH.
NAIL & SPOTTER IN NORTH SIDE U-POLE, WEST, 110.16 FT.
NAIL & SPOTTER IN EAST SIDE U-POLE, N03°W, 249.24 FT.
CENTERLINE OF M-37, WEST, 55.0 FT.
FACE OF STEEL ANCHOR POST, N30°W, 5.89 FT.

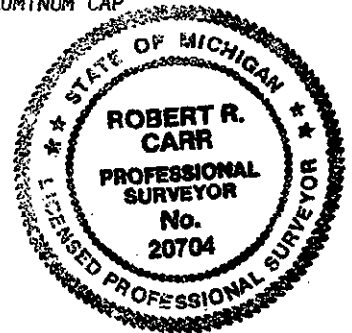

Signed by *Robert R. Carr*
Surveyor's Michigan License No. 20704

Date Nov 10, 1993