Darla K. Burghdoff - Barry Co.

LOCATION OF PROPERTY CONTROLLING CORNERS
T 1 N R 9 W
BARRY TOWNSHIP, BARRY COUNTY

9W

006

SURVEY & RECTIFICATION

MAR 01 2000

SECTION

Register of Deeds Stamp & File Number

MAY 7, 1999 do hereby state
of 1970, the corner points mentioned in lines 1
and rules therefore as required in the current
s Department of the Interior, Bureau of Land
or that the corner points mentioned in lines 3, 4
the Michigan Board of Land Surveyors or by a
d, monumented, recovered, found as expressed

own and range, may be recorded
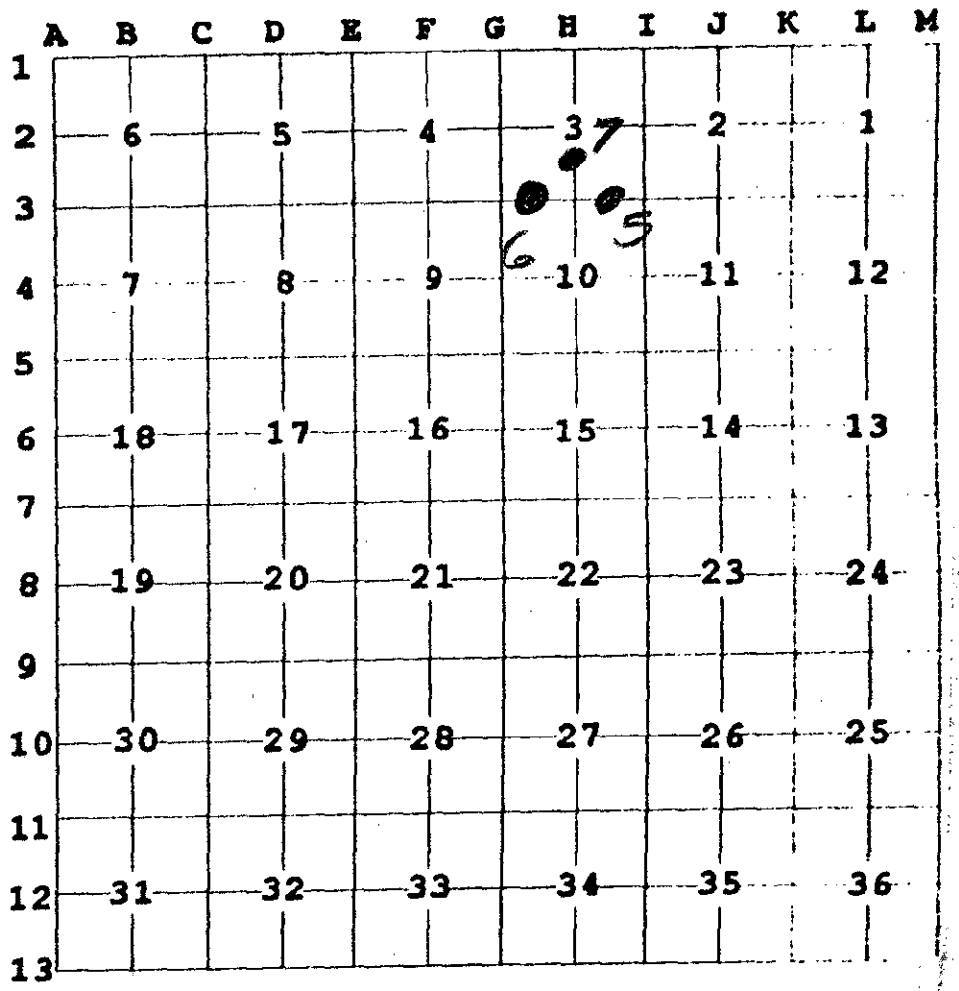
essories and/or subsequent restoration: