

**SURVEY & REMONUMENTATION**

1993

**COMMISSION**

**BARRY COUNTY REMONUMENTATION  
LAND CORNER RECORDATION CERTIFICATE  
Filing Requirement of Act 74, Mich. P.A. 1970**

STATE OF MICHIGAN  
COUNTY OF BARRY  
RECEIVED FOR RECORD

JUL 20 11 20 AM '93

Sandy Schonkelmar  
REGISTER OF DEEDS

For corners in

|                                    |                              |                |
|------------------------------------|------------------------------|----------------|
| <u>BARRY</u><br>(County)           | Located In:                  | Corner Code #/ |
|                                    | <u>BARRY</u>                 | <u>A-1</u>     |
| 1. Public Land Survey              | T <u>1N</u> R <u>9W</u>      | <u>M-1</u>     |
|                                    | <u>PRAIRIEVILLE</u> 1N R 10W | <u>M-13</u>    |
|                                    | <u>ORANGEVILLE</u> 2N R 10W  | <u>A-13</u>    |
|                                    | <u>HOPE</u> T 2N R 9W        |                |
| 2. Property Controlling in Section | S ___ T ___ R ___            |                |
| 3. Miscellaneous Property in Sec.  | S ___ T ___ R ___            |                |

002027

Register of Deeds Stamp & File Number

4. Lot No. \_\_\_\_\_, Recorded Plat \_\_\_\_\_  
5. Private Claims \_\_\_\_\_

T1N R9W T2E

|    |    |    |    |    |    |    |   |   |   |   |   |
|----|----|----|----|----|----|----|---|---|---|---|---|
| A  | B  | C  | D  | E  | F  | G  | H | I | J | K | L |
| 2  | 6  | 5  | 4  | 3  | 2  | 1  |   |   |   |   |   |
| 3  |    |    |    |    |    |    |   |   |   |   |   |
| 4  | 7  | 8  | 9  | 10 | 11 | 12 |   |   |   |   |   |
| 5  |    |    |    |    |    |    |   |   |   |   |   |
| 6  | 18 | 17 | 16 | 15 | 14 | 13 |   |   |   |   |   |
| 7  |    |    |    |    |    |    |   |   |   |   |   |
| 8  | 19 | 20 | 21 | 22 | 23 | 24 |   |   |   |   |   |
| 9  |    |    |    |    |    |    |   |   |   |   |   |
| 10 | 30 | 29 | 28 | 27 | 26 | 25 |   |   |   |   |   |
| 11 |    |    |    |    |    |    |   |   |   |   |   |
| 12 | 31 | 32 | 33 | 34 | 35 | 36 |   |   |   |   |   |
| 13 |    |    |    |    |    |    |   |   |   |   |   |

I, BRIAN REYNOLDS, in a field survey on JULY, 19 93, do hereby certify that under requirements of P.A. 74, Michigan P.A. of 1970, the corner points mentioned in lines 1 and 2 above were in conformance with regulations and rules therefore as required in the current manual of survey instructions of the United States Department of the Interior, Bureau of Land Management or by a decree of a Court of Law and/or that the corner points mentioned in lines 3, 4 and 5 above were in conformance with the rules of the Michigan Board of Land Surveyors or by a Decree of a Court of Law; established, re-established, monumented, re-monumented, recovered, found as expressed below:

**NOTE: Not more than 4 corners, all in the same town and range, may be recorded on this certificate.**

A. Description of original monument and accessories and/or subsequent restoration:

TOWNSHIP CORNER ESTABLISHED IN JANUARY, 1826 BY GENERAL LAND OFFICE DEPUTY SURVEYOR JOHN MULLETT. W. OAK 9 S23W 21 DO 8 S75E 90

CRESSY (1884) PRAIRIEVILLE RESURVEY FOUND OLD CORNER. TOOK NEW BEARINGS PUT IN TILE 3 FEET DEEP. HICKORY 8 S4W 38 1/2 W. O. 24 S75E 90 (L. 2, P. 242)

PRATT (L. 1, P. 333) SURVEY OF SEC. 6, T1N, R9W SEPTEMBER 6, 1888 W. O. 8 S75E 90 U.S.B.T. ALIVE MADE NEW HICK 8 S2°W .38

ADDITIONAL HISTORICAL INFORMATION ON BACK OF FORM

B. Description of corner evidence found and/or method applied in restoring or reestablishing corner:


FOUND CAPPED IRON (#12447 "IWM") IN 3" HOLLOW CLAY TILE AS PER L.C.R.C. #114. ALL WITNESSES FROM L.C.R.C. PRESENT AND CHECKED. ALSO FOUND WITNESS NAIL IN 12" MAPLE S8°E 12.15'

ACCEPTED AS A CAREFUL AND FAITHFUL PERPETUATION OF THE POSITION OF THE CORNER AS PREVIOUSLY CAREFULLY AND FAITHFULLY PERPETUATED BY CRESSY (1884).

C. Description of monument for corner and accessories established to perpetuate locating the position of the corner:

SET STANDARD 3/4" REMONUMENTATION IRON AND ALUMINUM CAP IN 3" CLAY TILE

- P.K. NAIL AND WITNESS TAG IN 24" HICKORY S4°W 25.49'
  - P.K. NAIL AND WITNESS TAG IN 12" HICKORY S76°W 27.26'
  - P.K. NAIL AND WITNESS TAG IN 12" CHERRY N46°W 19.02'
  - P.K. NAIL AND WITNESS TAG IN 12" CHERRY N67°E 16.13'
- FENCES SOUTH, EAST AND WEST

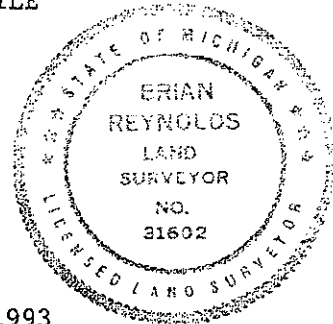

Signed by [Signature]

Date JULY 15, 1993

Surveyor's Michigan License No. 31602

PART "A" (CONTINUED)

BATEMAN (L. 3, P. 38) SURVEY OF SECTION 36, T2N, R10W  
AUGUST 17, 1900 TILE (NO WITNESSES)

L.C.R.C. #114 LARRY G. WATSON R.L.S. #12447 FEBRUARY 27, 1973

FOUND TILE

|     |      |       |        |
|-----|------|-------|--------|
| 12" | MAP. | NORTH | 22.23' |
| 15" | OAK  | WEST  | 30.43' |
| 12" | MAP. | EAST  | 35.00' |