

REVENUE

BARRY COUNTY REMONUMENTATION

AUG 22 1995

STATE OF MICHIGAN
COUNTY OF BARRY
RECEIVED FOR RECORD

JAN 25 8 35 AM '95

COMMISSIONER LAND CORNER RECORDATION CERTIFICATE
Filing Requirement of Act 74, Mich. P.A. 1970

Sandy Schindelmarper
REGISTER OF DEEDS

For corners in
BARRY

(County)

Located In:

Corner Code #

1. Public Land Survey 1/4 CORNER COMMON TO SECTIONS 6 & 7 BARRY TOWNSHIP	T	<u>1N</u>	R	<u>9W</u>	<u>B-3</u>
	T		R		
	T		R		
	T		R		
2. Property Controlling in Section	S		T	R	
	S		T	R	
3. Miscellaneous Property in Sec.	S		T	R	
	S		T	R	

002278

Register of Deeds Stamp & File Number

4. Lot No. _____, Recorded Plat _____
5. Private Claims _____

A	B	C	D	E	F	G	H	I	J	K	L	M
2	6	5	4	3	2							
3	●											
4	7	8	9	10	11	12						
5												
6	18	17	16	15	14	13						
7												
8	19	20	21	22	23	24						
9												
10	30	29	28	27	26	25						
11												
12	31	32	33	34	35	36						
13												

I, **BRIAN REYNOLDS**, in a field survey on 3 JUNE, 191994

do hereby certify that under requirements of P.A. 74, Michigan P.A. of 1970, the corner points mentioned in lines 1 and 2 above were in conformance with regulations and rules therefore as required in the current manual of survey instructions of the United States Department of the Interior, Bureau of Land Management or by a decree of a Court of Law and/or that the corner points mentioned in lines 3, 4 and 5 above were in conformance with the rules of the Michigan Board of Land Surveyors or by a Decree of a Court of Law; established, re-established; monumented, re-monumented, recovered, found as expressed below:

NOTE: Not more than 4 corners, all in the same town and range, may be recorded on this certificate.

A. Description of original monument and accessories and/or subsequent restoration:

- GENERAL LAND OFFICE: SYLVESTER SIBLEY, D.S., 1826 (R9W,P38), NOTES ARE AMBIGUOUS AS TO SURFACE CONDITIONS. "25.00 ENTER PRAIRIE 40.00 SET POST IN PRAIRIE A. W. OAK 10 N.89W. 450 Do. 14 S46 1/2W 441 43.00 LEFT MARSH"
- COUNTY SURVEYOR RECORDS: LEE S. COBB, 16 AUGUST, 1889, (LEE COBB BOOK IX, P.56) BOUNDARY OF CROOKED LAKE SUMMER RESORT, INDICATES IRON ROD 3/4" X 3FT. AND SMALL STONES 169 FEET WEST OF 1/4 CORNER BETWEEN SECTIONS 6 & 7.
- DESCRIPTION OF UNPLATTED LAND BORDERING CROOKED LAKE SUMMER RESORT, SURVEYOR AND DATE UNKNOWN, INDICATING PRECISE BEARINGS AND DISTANCES ALONG PLAT BOUNDARY WITH A PRECISE TIE TO 1/4 CORNER VIS. 168.12 FEET.
- NO OTHER RECORDED HISTORICAL INFORMATION AVAILABLE FOR THIS CORNER

B. Description of corner evidence found and/or method applied in restoring or reestablishing corner:


CROOKED LAKE (AND THE MARSH OR PRAIRIE BORDERING IT) IS SEVERAL FEET HIGHER IN 1994 THAN IT WAS AT THE TIME OF THE GENERAL LAND OFFICE SURVEY AND THE SURVEY BY COBB. INSTALLATION OF A CULVERT WHERE PARKER ROAD CROSSES THE NARROWS BETWEEN UPPER CROOKED AND LOWER CROOKED LAKES CAUSED THE RISE IN WATER LEVEL. TO ESTABLISH CORNER POSITION, FIRST LOCATED SEVERAL MONUMENTS ALONG BOUNDARY OF CROOKED LAKE SUMMER RESORT, TIED THEM IN AND COMPUTED A PROBABLE CORNER LOCATION. BORROWED AN ALUMINUM BOAT FROM A LOCAL PROPERTY OWNER, NAVIGATED TO COMPUTED POSITION, CHECKED WITH A MAGNETIC LOCATOR, RECEIVED INDICATION OF IRON MONUMENT BELOW WATER. LEFT THE BOAT AND IN APPROXIMATELY 4 1/2 FEET OF WATER, FOUND IRON WITH BARE FEET. TIED IN LOCATION FROM KNOWN POINT ON HIGH GROUND ALONG MARGIN OF CROOKED LAKE SUMMER RESORT.

C. Description of monument for corner and accessories established to perpetuate locating the position of the corner:

PLACED 3" X 9' IRON PIPE OVER TOP OF FOUND IRON, DRIVEN APPROXIMATELY 3' INTO MUCK BOTTOM OF MARSH, LEAVING 1 1/2' EXPOSED OVER WATER SURFACE.

ACT 345 BARRY COUNTY REMONUMENTATION SEE DETAILED SKETCH ON REVERSE SIDE
APPROVED BY PEER REVIEW AT A MEETING HELD ON

7 June '94
BRIAN REYNOLDS COUNTY SURVEYOR

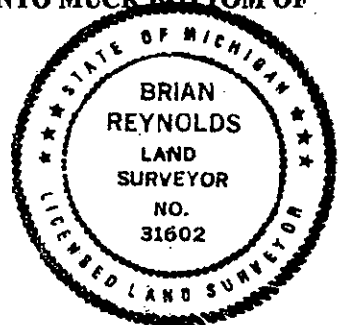

Signed by [Signature]
Surveyor's Michigan License No. 31602

Date JANUARY 25, 1995

