

SURVEY & REMONUMENTATION

STATE OF MICHIGAN  
COUNTY OF BARRY  
RECORDS & DEEDS

MAY 20 1997

BARRY COUNTY REMONUMENTATION  
LAND CORNER RECORDATION CERTIFICATE  
Filing Requirement of Act 74, Mich. P.A. 1970

DEC 9 2 09 PM '96

Sandy Schindelmarper  
REGISTER OF DEEDS

For corners in

COMMISSION

BARRY

(County)

Located in:

Corner Code #

- |   |  |            |
|---|--|------------|
| 1. Public Land Survey<br>SEC, CORNER COMMON<br>TO SEC'S 5&6<br>BARRY TWP. | T <u>1</u> N R <u>9</u> W              | <u>C-1</u> |
|   | T <u>   </u> R <u>   </u>              | <u>   </u> |
|   | T <u>   </u> R <u>   </u>              | <u>   </u> |
|   | T <u>   </u> R <u>   </u>              | <u>   </u> |
| 2. Property Controlling<br>in Section                                     | S <u>   </u> T <u>   </u> R <u>   </u> | <u>   </u> |
|   | S <u>   </u> T <u>   </u> R <u>   </u> | <u>   </u> |
| 3. Miscellaneous<br>Property in Sec.                                      | S <u>   </u> T <u>   </u> R <u>   </u> | <u>   </u> |
|   | S <u>   </u> T <u>   </u> R <u>   </u> | <u>   </u> |

002416

Register of Deeds Stamp & File Number

4. Lot No. \_\_\_\_\_, Recorded Plat \_\_\_\_\_  
5. Private Claims \_\_\_\_\_

I, RAYMOND MOORED, in a field survey on MAY, 19 95 do hereby state that under requirements of P.A. 74, Michigan P.A. of 1970, the corner points mentioned in lines 1 and 2 above were in conformance with regulations and rules therefore as required in the current manual of survey instructions of the United States Department of the Interior, Bureau of Land Management or by a decree of a Court of Law and/or that the corner points mentioned in lines 3, 4 and 5 above were in conformance with the rules of the Michigan Board of Land Surveyors or by a Decree of a Court of Law; established, re-established, monumented, recovered, found as expressed below:

NOTE: Not more than 2 corners, all in the same town and range, may be recorded on this certificate.

A	B	C	D	E	F	G	H	I	J	K	L	M
1												
2	6	5	4	3	2	1						
3												
4	7	8	9	10	11	12						
5												
6	18	17	16	15	14	13						
7												
8	19	20	21	22	23	24						
9												
10	30	29	28	27	26	25						
11												
12	31	32	33	34	35	36						
13												

A. Description of original monument and accessories and/or subsequent restoration:

GLO SYLVESTER SIBLEY, D.S. 1826 (R9W, P.39) INTERSECTED BOUNDARY 242 EAST OF POST A MAPLE 10 S69E 39 A WILLOW 6 S40W 50 BARRY TWP FIELD PRATT PG. 1 MAPLE 10 S49W 2.05 1/2 DOUBLE BOOK SERIES #2 FLO BK SERIES #2 PG 12 7" ELM N 833/4 E 137 FEET BATEMAN 1900 (L 1 P.348) & (L.3, P.28) IRON 10" HICKORY S 113/4 W 217 FEET LEE COBB 1895 SET STONE 21X19X12 & BRICK BUTTERNUT 8 S73DEGW 1 1/2 STAKE, STONE, IRON, BRICK S40 1/2 DEG. E 62 1.2 (L2, P37) - F.S. BOWEN FOUND BY U.S. BEARINGS NO NAME OR DATE IN OLD RECORDS. C-1 OLD SURVEY SHOWING CORNER TO BE 965.5' EAST OF CENTERLINE OF HIGHWAY M-43. FOUND IRON PIPE. 2" IRON PIPE. CENTERLINE CREEK NORTH 8' 6" BEECH, EAST 33.33'. 4" CHERRY, N05DEG +W, 3.25'. (ACT 132 SURVEY L.1, P.164) 2-19-1974-165 ALLEN H. MCMACHEN RLS #16935. (ACT 132 SURVEY L.1, P.709) ROBERT R. CARR RLS #20704 MARCH 31, 1982

B. Description of corner evidence found and/or method applied in restoring or reestablishing corner: (CONTINUED ON BACK)

FOUND PIPE PER LCRC #338 BY CARR. FOUND POSITION FALLS SHORT OF TOWN LINE BY 9.35 FEET. SET REMON IRON BY EXTENDING LINE FROM C-2 THROUGH FOUND PIPE AND INTERSECTING TOWN LINE BETWEEN D-13 AND C-13. ACCEPTED POSITION AS BEST AVAILABLE EVIDENCE OF CORNER POSITON. SET STANDARD BARRY COUNTY REMON IRON W/CAP.


ACT 345 BARRY COUNTY REMONUMENTATION  
APPROVED BY PEER REVIEW AT A MEETING HELD ON

9 OCT. '95  
BRIAN REYNOLDS

*BR*  
COUNTY SURVEYOR

C. Description of monument for corner and accessories established to perpetuate locating the position of the corner:

- SET STANDARD BARRY COUNTY REMON IRON WITH CAP
- 2" IRON PIPE SOUTH 9.35'
- IRON FALLS IN CENTER OF DITCH
- NAIL IN N SIDE 10" BEECH S 85 DEG. E 34.59'
- NAIL IN E SIDE 8" CHERRY S5DEG W 6.22'
- SW COR SEC. 32 HOPE TWP 168.60'

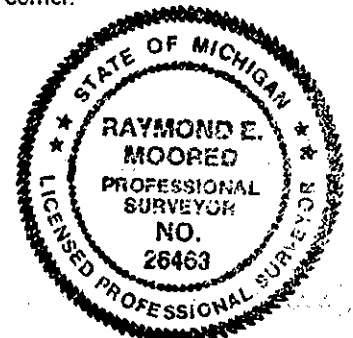

Signed by Raymond Moored  
Surveyor's Michigan License No. 26463

Date 11/4/96

2416-A

341' EAST OF C.K. & S. R.R. BARCH CHIEF ENGINEER 5 DEC.  
1887 (LIBE 1 OF PLATS, PAGE 35)

SURVEY &  
REMONUMENTATION

MAY 20 1997

COMMISSION