

**SURVEY & REMONUMENTATION**

MAY 20 1997

**COMMISSION**

**BARRY COUNTY REMONUMENTATION  
LAND CORNER RECORDATION CERTIFICATE  
Filing Requirement of Act 74, Mich. P.A. 1970**

STATE OF MICHIGAN  
COUNTY OF BARRY  
RECORDS DEPARTMENT

Dec 9 2 09 PM '96

Sandy Schuchelmar  
REGISTER OF DEEDS

**002418**

Register of Deeds Stamp & File Number

For corners in

<u>BARRY</u> (County)	Located In:	Corner Code #
1. Public Land Survey	T <u>1</u> N R <u>9</u> W	<u>D-1</u>
CORNER COMMON TO	T <u>   </u> R <u>   </u>	<u>   </u>
SEC. 5	T <u>   </u> R <u>   </u>	<u>   </u>
BARRY TWP.	T <u>   </u> R <u>   </u>	<u>   </u>
2. Property Controlling	S <u>   </u> T <u>   </u> R <u>   </u>	<u>   </u>
in Section	S <u>   </u> T <u>   </u> R <u>   </u>	<u>   </u>
3. Miscellaneous	S <u>   </u> T <u>   </u> R <u>   </u>	<u>   </u>
Property in Sec.	S <u>   </u> T <u>   </u> R <u>   </u>	<u>   </u>

4. Lot No. \_\_\_\_\_, Recorded Plat \_\_\_\_\_  
5. Private Claims \_\_\_\_\_

I, RAYMOND MOORED, in a field survey on MAY, 1995 do hereby state that under requirements of P.A. 74, Michigan P.A. of 1970, the corner points mentioned in lines 1 and 2 above were in conformance with regulations and rules therefore as required in the current manual of survey instructions of the United States Department of the Interior, Bureau of Land Management or by a decree of a Court of Law and for that the corner points mentioned in lines 3, 4 and 5 above were in conformance with the rules of the Michigan Board of Land Surveyors or by a Decree of a Court of Law, established, re-established, monumented, recovered, found as expressed below:

NOTE: Not more than 2 corners, all in the same town and range, may be recorded on this certificate.

	A	B	C	D	E	F	G	H	I	J	K	L	M
1													
2	6			5			4			3		2	1
3													
4	7			8			9			10		11	12
5													
6	18			17			16			15		14	13
7													
8	19			20			21			22		23	24
9													
10	30			29			28			27		26	25
11													
12	31			32			33			34		35	36
13													

A. Description of original monument and accessories and/or subsequent restoration:

COUNTY SURVEYOR STAKE SET BY BATEMAN FOR 1/4 CORNER N. SIDE SEC. 5 HEATH (TAN BARRY TWP. F.B, P.31) BEECH 30 S 89 1/2 E. 20 1/4 13.36. BEECH 10 N. 20 W. 20 13.2. S. WILSON BROWN BARRY TWP. F.B. P. 84 SET POST & TOOK BEARINGS W. ASH 16 S 70 W. 23 1/2 BEECH 12 S 59 E. STAKE S.66 1/2 W. 12 A. IS A 20" BEECH A.N. BATEMAN (L3, P.28) & (L.1, P.348) E. 13 1/2 FT. IS A 30" BEECH APRIL 6 AND 14, 1900. W OK 10 N 89 W. 450 W. OK 14 S 46 1/2 W. 441 (TAN BARRY TWP. F.B, P. 16)

B. Description of corner evidence found and/or method applied in restoring or reestablishing corner:


FD NO EVIDENCE OF CORNER LOCATION ESTABLISHED CORNER BY EXTENDING LINE FROM S 1/4 POST THROUGH CENTER OF SECTION AND INTERSECTING TOWN LINE. ACCEPTED AS BEST AVAILABLE EVIDENCE OF CORNER LOCATION SET STANDARD BARRY COUNTY REMON IRON W/CAP.

ACT 345 BARRY COUNTY REMONUMENTATION  
APPROVED BY PEER REVIEW AT A MEETING HELD ON

9 Oct. 95 BR  
BRIAN REYNOLDS COUNTY SURVEYOR

C. Description of monument for corner and accessories established to perpetuate locating the position of the corner:

STANDARD BARRY COUNTY REMON IRON W/CAP  
-NAIL IN N. SIDE 36" BEECH EAST 19.95'  
-NAIL IN NE SIDE 24" BEECH S 45E. 48.06'  
-NAIL IN SW SIDE 24" OAK S. 30 E. 40.99'  
-NAIL IN N SIDE 12" OAK WEST 13.15'  
-CENTERLINE BRICKYARD ROAD NORTH 40'+  
-S 1/4 CORNER SECTION 32 HOPE WEST 142.56'

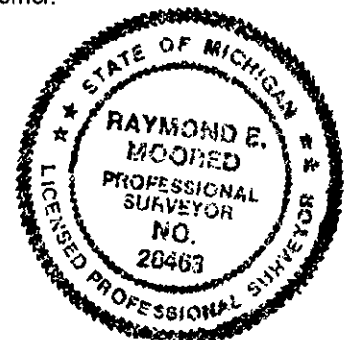

Signed by Raymond Moored  
Surveyor's Michigan License No. 26463

Date 11/4/96