

**SURVEY & REMONUMENTATION**

MAY 20 1997

COMMISSION

**BARRY COUNTY REMONUMENTATION  
LAND CORNER RECORDATION CERTIFICATE**  
Filing Requirement of Act 74, Mich. P.A. 1970

STATE OF MICHIGAN  
COUNTY OF BARRY  
RECEIVED

DEC 9 2 09 PM '96

Sandy Schindlermayer  
REGISTER OF DEEDS

002420


Register of Deeds Stamp & File Number

For corners in BARRY (County)

	Located In:	Corner Code #
1. Public Land Survey C1/4 COR. TO SEC. 5 BARRY TWP.	T <u>1</u> N R <u>9</u> W	<u>D-2</u>
2. Property Controlling in Section	S <u>   </u> T <u>   </u> R <u>   </u>	<u>   </u>
3. Miscellaneous Property in Sec.	S <u>   </u> T <u>   </u> R <u>   </u>	<u>   </u>

4. Lot No. \_\_\_\_\_, Recorded Plat \_\_\_\_\_

5. Private Claims \_\_\_\_\_

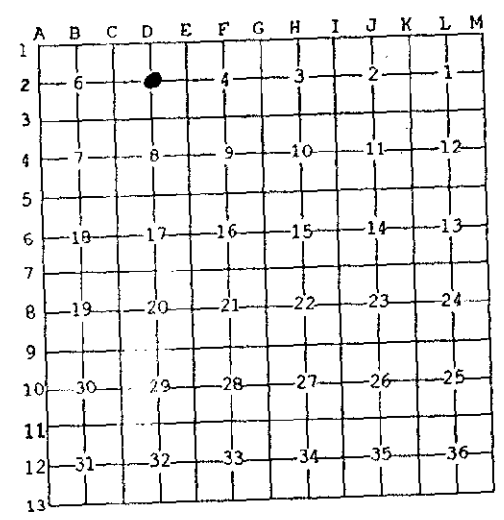

I, RAYMOND MOORED, in a field survey on MAY, 1995 do hereby state that under requirements of P.A. 74, Michigan P.A. of 1970, the corner points mentioned in lines 1 and 2 above were in conformance with regulations and rules therefore as required in the current manual of survey instructions of the United States Department of the Interior, Bureau of Land Management or by a decree of a Court of Law and for that the corner points mentioned in lines 3, 4 and 5 above were in conformance with the rules of the Michigan Board of Land Surveyors or by a Decree of a Court of Law; established, re-established, monumented, recovered, found as expressed below:

NOTE: Not more than 2 corners, all in the same town and range, may be recorded on this certificate.

A. Description of original monument and accessories and/or subsequent restoration:

G.L.O.- CORNER NOT SET BY G.L.O. COUNTY SURVEYOR RECORDS HEATH (TAN BARRY F.B., PG 34) SET DRAG TOOTH AT 40 CHS. CENTER TO BE ASERTAINED WHEN FROST IS OUT. COBB 5-12-13 BROWN BARRY F.B., PG 84; TAN BARRY F.B., PG. 34- FOUND OLD STAKE, SET STONE 24" X 12" X 12" & BRICK; HICKORY 12 NE 35; HICKORY 12 SE 76. (L. 1, PG. 37). WILLSON- BRN BARRY F.B. PG. 84, SET POST AT INTERSECTION OF 1/4 LINES. F.S. BOWEN (L. 2, PG. 37) B. OAK 36 S73E 130; LYNN 20 N71E 1.74 1/2. CO. ROAD COMM.- PLEASANT LAKE ROAD, PG. 1 NO DATE - FD. IRON IN PAVEMENT C/L. USGS MON S45W 40.00'; 20" ASH S54E 49.7'; 20" HICKORY N25E 23.3'; 1927 PIFER & ORCHARD ROAD PLANS, PG. 4- STA 33+01.1, 18" HICKORY N34-30E 23.0'; 12" ASH S53-30E 50.5'. CORNER SHOWN ON RECORDED SURVEY BY ROY F. DEHAVEN (P.S. # 3380) RECORDED 2-26-75

B. Description of corner evidence found and/or method applied in restoring or reestablishing corner:

FOUND IRON IN CENTERLINE OF ORCHARD ROAD PER ROAD COMM. STATIONING AND DEHAVEN SURVEY. LOCATION MATCHES IRONS IN PLAT OF BILL SMITH PLAT TO WEST AND SOUTH. ACCEPTED FOUND IRON AS BEST AVAILABLE EVIDENCE OF CORNER LOCATION. SET STANDARD BARRY COUNTY REMONUMENTATION IRON WITH CAP.

ACT 345 BARRY COUNTY REMONUMENTATION  
APPROVED BY PEER REVIEW AT A MEETING HELD ON  
9 OCT. 95  
BRIAN REYNOLDS COUNTY SURVEYOR



C. Description of monument for corner and accessories established to perpetuate locating the position of the corner:

SET STANDARD BARRY COUNTY REMONUMENTATION IRON WITH CAP.  
-NAIL & TAG IN S. SIDE 10" HICKORY N45E 49.77'  
-NAIL & TAG IN SE SIDE 36" TWIN OAK S50W 70.41'  
-NAIL & TAG IN S SIDE POWER POLE N60W 84.91'  
-TOP CENTERLINE OF FIRE HYDRANT S45E 54.28'  
-IN CENTER OF ORCHARD AND PLEASANT LAKE ROADS

Signed by Raymond Moored  
Surveyor's Michigan License No. 26463

Date 11/4/96