

MAY 20 1997

COMMISSION

For corners in BARRY

(County)

BARRY COUNTY REMONUMENTATION

LAND CORNER RECORDATION CERTIFICATE
Filing Requirement of Act 74, Mich. P.A. 1970

STATE OF MICHIGAN
COUNTY OF BARRY
RECEIVED

DEC 9 2 09 PM '96

Sandy Schmalzmaier
REGISTER OF DEEDS

002421

Register of Deeds Stamp & File Number

	Located In:	Corner Code #
1. Public Land Survey SEC COR. COMMON TO SEC'S. 4 & 5 BARRY TWP.	T 1N R 9W	E-1
	T R	
	T R	
	T R	
	T R	
2. Property Controlling in Section	S T R	
	S T R	
3. Miscellaneous Property in Sec.	S T R	
	S T R	

4. Lot No. _____, Recorded Plat _____
5. Private Claims _____

RAYMOND MOORED

I, _____, in a field survey on MAY, 1995 do hereby state that under requirements of P.A. 74, Michigan P.A. of 1970, the corner points mentioned in lines 1 and 2 above were in conformance with regulations and rules therefore as required in the current manual of survey instructions of the United States Department of the Interior, Bureau of Land Management or by a decree of a Court of Law and /or that the corner points mentioned in lines 3, 4 and 5 above were in conformance with the rules of the Michigan Board of Land Surveyors or by a Decree of a Court of Law, established, re-established, monumented, recovered, found as expressed below:

NOTE: Not more than 2 corners, all in the same town and range, may be recorded on this certificate.

A	B	C	D	E	F	G	H	I	J	K	L	M
1												
2	6		5		4		3		2		1	
3												
4	7		8		9		10		11		12	
5												
6	18		17		16		15		14		13	
7												
8	19		20		21		22		23		24	
9												
10	30		29		28		27		26		25	
11												
12	31		32		33		34		35		36	
13												

A. Description of original monument and accessories and/or subsequent restoration:

GLO SYLVESTER SIBLEY D.S. 1826 (R9W, P.32) NORTH 87.32 INTERSECTED N. BOUNDARY 1.65 EAST OF POST. A. TAMARACK 6. S.69E. 71 DO 6 S.62 W. 22 COUNTY SUR. REC. (TAN BARRY TWP.F.B,P.15) STONE TAM 6. S69E 71" 6 S.62W 22. (TAN BARRY TWP.F.B,P.31) TAMARACK 7 S88 1/4 W 40 1/4 TAMARACK 7 S12 W. 16 3/4 BATEMAN APRIL 1900 (L.1,P.348)&(L.3,P.28) IRON, BRICK, & STAKE. S.56 3/4 W. 64FT. 14' PINE S 11 W 11FT. 10" TAMARACK S61 DEG E 73FT 16; PINE

B. Description of corner evidence found and/or method applied in restoring or reestablishing corner:


FOUND BUGGY SPRING BELIEVED TO BE CORNER AS RECITED BY BATEMEN IN PART A ABOVE. CORNER HAD BEEN PREVIOUSLY FOUND AND USED BY KING & RYAN SURVEYORS IN EARLY 1990'S. ACCEPTED FOUND IRON AS BEST AVAILABLE EVIDENCE OF CORNER LOCATION. SET STANDARD BARRY COUNTY REMONUMENTATION IRON WITH CAP.

ACT 345 BARRY COUNTY REMONUMENTATION
APPROVED BY PEER REVIEW AT A MEETING HELD ON

9 OCT. 95 BR
BRIAN REYNOLDS COUNTY SURVEYOR

C. Description of monument for corner and accessories established to perpetuate locating the position of the corner:

- SET STANDARD BARRY COUNTY REMONUMENTATION IRON WITH CAP.
- NAIL & TAG IN N SIDE 14" MAPLE N90E 1.17'
- NAIL & TAG IN S SIDE 3" MAPLE N85W 8.30'
- NAIL & TAG IN N SIDE 5" MAPLE S85W 13.28'
- NAIL & TAG IN S SIDE 8" HACKBERRY N87W 57.65'
- SE COR SEC. 32, HOPE (E-13) WEST 85.14'

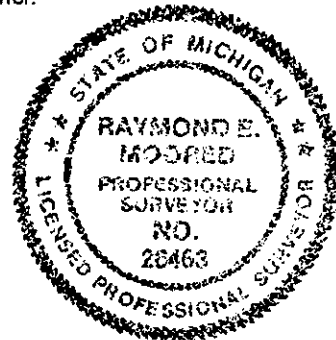

Signed by Raymond Moored
Surveyor's Michigan License No. 26463

Date 11/4/96