

AUG 22 1995

COMMISSION

BARRY COUNTY REMONUMENTATION

LAND CORNER RECORDATION CERTIFICATE
Filing Requirement of Act 74, Mich. P.A. 1970

STATE OF MICHIGAN
COUNTY OF BARRY
RECEIVED FOR RECORD

JAN 25 8 35 AM '95

Sandra Schondelmayer
REGISTER OF DEEDS

For corners in
BARRY
(County)


Located In: Corner Code #

Table with 3 columns: Description, Located In (T, R, S), and Corner Code #. Includes items like Public Land Survey, Property Controlling, and Miscellaneous Property.

002279

Register of Deeds Stamp & File Number

4. Lot No. Recorded Plat
5. Private Claims

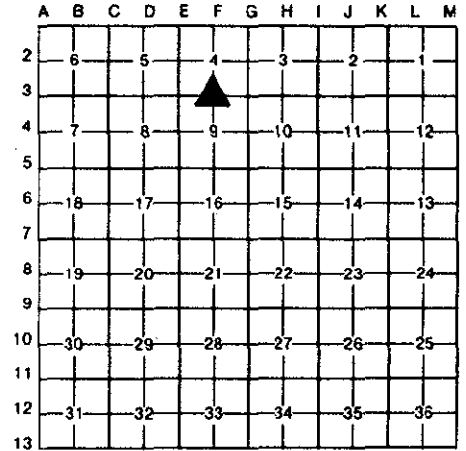

I, BRIAN REYNOLDS, in a field survey on 26 JANUARY 1993, do hereby certify that under requirements of P.A. 74, Michigan P.A. of 1970, the corner points mentioned in lines 1 and 2 above were in conformance with regulations and rules therefore as required in the current manual of survey instructions of the United States Department of the Interior, Bureau of Land Management or by a decree of a Court of Law and/or that the corner points mentioned in lines 3, 4 and 5 above were in conformance with the rules of the Michigan Board of Land Surveyors or by a Decree of a Court of Law; established, re-established, monumented, re-monumented, recovered, found as expressed below:

NOTE: Not more than 4 corners, all in the same town and range, may be recorded on this certificate.

A. Description of original monument and accessories and/or subsequent restoration:

- 1 GENERAL LAND OFFICE: SYLVESTER SIBLEY D.S., 1826 (R9W, Pg. 3) WEST CORRECTED 39.78ch. A B. OAK - 7 - N31W - 18; A W. OAK - 30 - N73E - 24.
2 DON DAVIS: P.S. # 17617, 2/12/92: 5/8" IRON IN ROCK: TW 14" OAK - S40W - 41.1'; 8" HICK - WEST - 18.2'; 1' NORTH OF 15" RED OAK.
3 UNRECORDED SURVEY BY JOHN C. HUNT: P.S. #23513, SOUTHWEST SURVEY & ENGINEERING CO., INC, SURVEY FOR Dr. JAMES HUNT, JOB # 93-13814, 6/17/93: FOUND 1/2" IRON 1' N. OF WOVEN WIRE FENCE TO EAST: N&T - N. FACE - 21" OAK - S. - 0.50'; N&T - E. FACE - 15" POPLAR - N. - 48.00' N&T - N. FACE - 15" OAK - W. - 31.92'; N&T - N. BASE OF TWIN 18" - 22" OAK - S60W - 39.38'

B. Description of corner evidence found and/or method applied in restoring or reestablishing corner:


FOUND 1/2" IRON AND WITNESSES MATCHING THOSE OF JOHN C. HUNT & DON DAVIS. ALSO FOUND TRACES OF FENCE TO THE SOUTH, EAST, AND WEST. ACCEPTED 1/2" IRON AS PERPETUATION OF THE 1/4 CORNER. LEFT FOUND 1/2" IRON IN PLACE

ACT 345 BARRY COUNTY REMONUMENTATION
APPROVED BY PEER REVIEW AT A MEETING HELD ON

19 April '94 BR
BRIAN REYNOLDS COUNTY SURVEYOR

C. Description of monument for corner and accessories established to perpetuate locating the position of the corner:

- FOUND 1/2" IRON FIRMLY GROWN INTO ROOTS OF OAK TO SOUTH:
FOUND SPIKE TWIN 14" OAK S40°W 41.1'
FOUND SPIKE 8" HICKORY WEST 18.2'
FOUND NAIL W/TAG NORTH SIDE 21" OAK SOUTH 0.50'
FOUND NAIL W/TAG EAST SIDE 15" POPLAR NORTH 48.00'
FOUND NAIL W/TAG NORTH SIDE 15" OAK WEST 31.92'
FOUND NAIL W/TAG NORTH BASE OF TWIN 20" OAK S60°W 39.38'

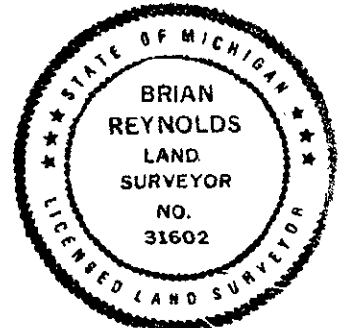

Signed by [Signature]
Surveyor's Michigan License No. 31602

Date JANUARY 24, 1995