

FEB 03 1999

LAND CORNER RECORDATION CERTIFICATE
Filing Requirement of Act 74, Mich. P.A. 1970

SECTION

For Corners in BARRY (county)
Located In: _____ Corner Code # _____

1. Public Land Survey
1/4 CORNER COMMON TO
SECTIONS 16 & 21
BARRY TOWNSHIP

T 1N R 9W F-7
T _____ R _____
T _____ R _____
T _____ R _____



2756
Page: 1 of 1
12/17/1998 12:35P

Sandy Schonhelmayer - Barry Co. LCRCR

Register of Deeds Stamp & File Number

2. Property Controlling in Section S _____ T _____ R _____
S _____ T _____ R _____

3. Miscellaneous S _____ T _____ R _____

4. Lot No _____ Recorded Plat _____

5. Private Claims _____

	A	B	C	D	E	F	G	H	I	J	K	L	M
1													
2	6		5		4		3		2		1		
3													
4	7		8		9		10		11		12		
5													
6	18		17		16		15		14		13		
7													
8	19		20		21		22		23		24		
9													
10	30		29		28		27		26		25		
11													
12	31		32		33		34		35		36		
13													

I, Brian Reynolds, in a field survey on 15 MAY, 1998 do hereby certify that under requirements of P.A. 74, Michigan P.A. of 1970, the corner points mentioned in lines 1 and 2 above were in conformance with regulations and rules therefore as required in the current manual of survey instructions of the United States Department of the Interior, Bureau of Land Management or by a decree of a Court of Law and/or that the corner points mentioned in lines 3, 4, and 5 above were in conformance with the rules of the Michigan Board of Land Surveyors or by a Decree of a Court of Law; established, re-established, monumented, re-monumented, recovered, found as expressed below.
NOTE: Not more than 2 corners, all in the same town and range, may be recorded on this certificate.

- A. Description of original monument and accessories and/or subsequent restoration:
- GENERAL LAND OFFICE: SYLVESTER SIBLEY, D.S., 1826 (R9W, P. 29) W. OAK 10 N55W 12 Do. 12 N46E 29
 - COUNTY SURVEYOR RECORDS: LEE S. COBB, 30-31 MARCH, 1893 (TAN BARRY F.B., P. 9)(BROWN BARRY F.B., P.88)
 - "FOUND ONE U.S. TREE" "SET SASSAFRAS STAKE & PILE OF STONES" W. OAK 12 N46E 29
PRIVATE NOTES: DON DAVIS, NO DATE, FROM FIELD BOOK, JOB #378 "5/8" IRON" 10" CHERRY N80°E 18.5'
24" OAK S80°W 17.5' TWIN 20" OAK S05°W 7.0'
 - PRIVATE NOTES: BRIAN REYNOLDS, P.S. #31602 JOB # 94314, JULY 1994, "FOUND 1/4" IRON AS PER WITNESSES, SURROUNDED WITH STONES" 40± SOUTH OF EDGE OF FIELD 20± NORTHWEST OF POND
N&T N FACE 12" CHERRY N86°W 23.52' N&T SE FACE 8" OAK S52°W 22.60' N&T NE FACE 10" MULBERRY S24°W 14.54'
N&T S FACE 12" BLK CHERRY N80°E 11.94' N&T S FACE 12" HICKORY N64°E 19.90'


B. Description of corner evidence found and/or method applied in restoring or reestablishing corner:
FOUND 1/4" IRON SURROUNDED BY STONES AND ALL WITNESSES AS RECITED IN #3 & #4 ABOVE.
BELIEVE STONES AROUND FOUND IRON TO BE "PILE OF STONES" RECITED BY COBB.
PERPETUATED BY DAVIS.
SET STANDARD BARRY COUNTY REMONUMENTATION ALUMINUM CAP ON FOUND 1/4" IRON.

C. Description of monument for corner and accessories established to perpetuate locating the position of the corner:
SET STANDARD BARRY COUNTY REMONUMENTATION ALUMINUM CAP ON FOUND 1/4" IRON
40± SOUTH OF EDGE OF FIELD 20± NORTHWEST OF POND
FOUND 20d NAIL W/PLASTIC TAG IN THE NORTH SIDE 12" CHERRY N86°W 23.52'
FOUND 20d NAIL W/PLASTIC TAG IN THE SOUTHWEST SIDE 8" OAK S52°W 22.60'
FOUND 20d NAIL W/PLASTIC TAG IN THE NORTHEAST SIDE 10" MULBERRY S24°W 14.54'
FOUND 20d NAIL W/PLASTIC TAG IN THE SOUTH SIDE 12" BLACK CHERRY N80°E 11.94'
FOUND 20d NAIL W/PLASTIC TAG IN THE SOUTH SIDE 12" HICKORY N64°E 19.90'

ACT 345 BARRY COUNTY REMONUMENTATION
APPROVED BY PEER REVIEW AT A MEETING HELD ON

14 Sept. 98 BR
BRIAN REYNOLDS COUNTY SURVEYOR

Signed by [Signature]
Surveyor's Michigan License No 31602

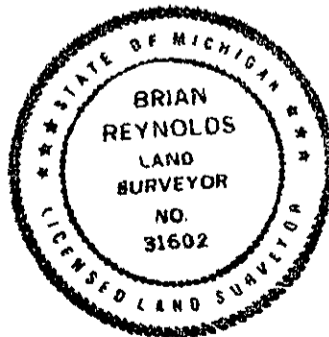

Date DEC 15, 1998
FORM APPROVED BY MICHIGAN STATE BOARD OF LAND SURVEYORS, JAN. 28, 1971
REVISED MAY 14, 1975 REVISED JANUARY, 1983 REVISED OCTOBER 1985