**BARRY COUNTY REMONUMENTATION**
**LAND CORNER RECORDATION CERTIFICATE**
**Filing Requirement of Act 74, Mich. P.A. 1970**

SURVEY & REMONUMENTATION
APR 04 2000
SECTION

For corners in

BARRY (County)

| | Located In: | Corner Code # |
|---|---|---|
| BARRY TOWNSHIP | | |
| 1. Public Land Survey | T 1N R 9W | G-2 |
| | T___ R___ | |
| | T___ R___ | |
| | T___ R___ | |
| 2. Property Controlling | S___ T___ R___ | |
| in Section | S___ T___ R___ | |
| 3. Miscellaneous | S___ T___ R___ | |
| Property in Sec. | S___ T___ R___ | |

Darla K. Burghdoff- Barry Co. LCRCR

**2797**
**Page: 1 of 1**
12/07/1999 08:36A

**Register of Deeds Stamp & File Number**

4. Lot No. _____ , Recorded Plat _____
5. Private Claims _____

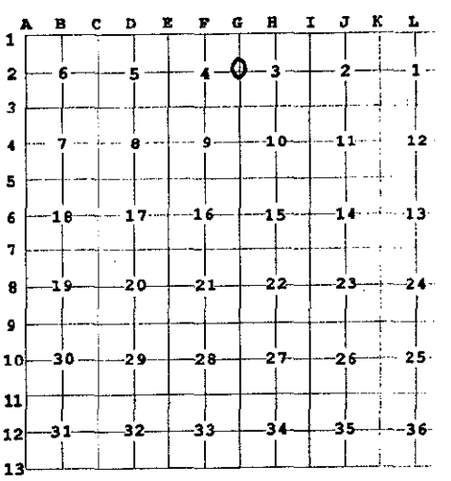


I, ROBERT R. CARR , in a field survey on MAY 7 , 19 99 do hereby state that under requirements of P.A. 74, Michigan P.A. of 1970, the corner points mentioned in lines 1 and 2 above were in conformance with regulations and rules therefore as required in the current manual of survey instructions of the United States Department of the Interior, Bureau of Land Management or by a decree of a Court of Law and /or that the corner points mentioned in lines 3, 4 and 5 above were in conformance with the rules of the Michigan Board of Land Surveyors or by a Decree of a Court of Law; established, re-established, monumented, recovered, found as expressed below:

**NOTE: Not more than 2 corners, all in the same town and range, may be recorded on this certificate.**

A. Description of original monument and accessories and/or subsequent restoration:

G.L.O. ORIGINAL CORNER SET BY SYLVESTER SIBLEY, D.S. 1826
A.C. WILLSON, COUNTY SURVEYOR 1880 FOUND POST SET BY MANCHESTER
PLANTED STAKE, STONE & CROCKERY.
S. PRATT, COUNTY SURVEYOR, 1888 STAKE, STONE & CROCKERY WITH TWO WITNESSES.
PLAT OF "NORTHBAY" BY W.H. ROGERS, 1958, TIED TO CORNER.
C. PIKE/DEKEYSER & ASSOCIATES, 1969, IRON WITH FOUR WITNESSES.
BRIAN REYNOLDS, P.S. NO. 31602, 1992,
SET 1/2" IRON, FROM MONUMENTATION OF PLAT OF "NORTHBAY".
RAYMOND E. MOORED P.S. NO. 26463, 1997,
FOUND IRON, TOOK NEW WITNESSES.

B. Description of corner evidence found and/or method applied in restoring or reestablishing corner:

FOUND STAKE MATCHING REMAINING WITNESSES BY REYNOLDS AND MOORED.
AREA HAS BEEN HEAVILY EXCAVATED WITH ROAD CONSTRUCTION.
*WITH NO REMAINING EVIDENCE OF OLDER RESTORATION, I ACCEPTED THE EXISTING*
IRON AS PLACED BY REYNOLDS AS THE BEST EVIDENCE OF THE ORIGINAL CORNER.

ACT 345 BARRY COUNTY REMONUMENTATION
APPROVED BY PEER REVIEW AT A MEETING HELD ON
13 SEPT 99 BR
BRIAN REYNOLDS COUNTY SURVEYOR

C. Description of monument for corner and accessories established to perpetuate locating the position of the corner:

BARRY COUNTY REMONUMENTATION STAKE AND BRASS CAP
20" OAK, S69°E 123.57 FEET, SET BARRY COUNTY SPOTTER
TELEPHONEN RISER S60°E, 101.10 FEET.
8" OAK, S81°W 115.60 FEET, SET BARRY COUNTY SPOTTER
UTILITY POLE, N28°W 48.92 FEET, SET BARRY COUNTY SPOTTER

STATE OF MICHIGAN
ROBERT R. CARR
PROFESSIONAL SURVEYOR
NO.

Signed by _____ Date NOV. 22, 1999

Surveyor's Michigan License No. 20704 ROBERT R. CARR

FORM APPROVED BY MICHIGAN STATE BOARD OF PROFESSIONAL SURVEYORS, JAN. 28, 1
REVISED MAY 14,1
REVISED JAN., 1
REVISED OCT., 1