

OCT 27 1994

COMMISSION

BARRY COUNTY REMONUMENTATION

STATE OF MICHIGAN COUNTY OF BARRY RECEIVED FOR RECORD

OCT 7 2 04 PM '94

LAND CORNER RECORDATION CERTIFICATE Filing Requirement of Act 74, Mich. P.A. 1970

For corners in BARRY

(County)

Located In:

Corner Code #

- 1. Public Land Survey CORNER COMMON TO SECTIONS 15,16,21, AND 22 BARRY TOWNSHIP
2. Property Controlling in Section
3. Miscellaneous Property in Sec.
T 1N R 9W G-7

Sandy Schondelmayer REGISTER OF DEEDS

002233

Register of Deeds Stamp & File Number

- 4. Lot No.
5. Private Claims

BRIAN REYNOLDS in a field survey on 13 JULY 1994 do hereby certify that under requirements of P.A. 74, Michigan P.A. of 1970, the corner points mentioned in lines 1 and 2 above were in conformance with regulations and rules therefore as required in the current manual of survey instructions of the United States Department of the Interior, Bureau of Land Management or by a decree of a Court of Law and/or that the corner points mentioned in lines 3, 4 and 5 above were in conformance with the rules of the Michigan Board of Land Surveyors or by a Decree of a Court of Law; established, re-established, monumented, re-monumented, recovered, found as expressed below:

NOTE: Not more than 4 corners, all in the same town and range, may be recorded on this certificate.

A. Description of original monument and accessories and/or subsequent restoration:

- 1 GENERAL LAND OFFICE: SYLVESTER SIBLEY, D.S., 1826 (R9W,P.23) A. W. OAK 11 S78E 29 Do. 20 N81W 34
2 COUNTY SURVEYOR RECORDS: LEE COBB, MARCH 30-31, 1893 (TAN BARRY TWP. F.B.,P.9) PUT IN MOWING MACHINE AXLE AND STONES
ALSO: LEE COBB, 1893,(BROWN BARRY TWP. F.B., P.88) FOUND STAKE STONE AND PLOW POINT SET MOWING MACHINE AXLE AND PLOW POINT
3 SURVEY BY JAMES L. KING, P.S. # 14766, MAY 1974, (LCRC #172) 1" IRON, 24" OAK S20E 48.51' 12" OAK N30E 27.12' 4'+/- EAST OF CENTERLINE OF N/S ROAD
4 SURVEY BY DONALD J. DAVIS, P.S. #17617, NOV. 1973, (ACT 132 SURVEY, L.1,P.255) 1" IRON 24" OAK S20E 48.51' 12" OAK N30E 27.12'

B. Description of corner evidence found and/or method applied in restoring or reestablishing corner:

FOUND 1" IRON AND BOTH OAK TREES AS DESCRIBED BY KING AND DAVIS. EXCAVATED AROUND 1" IRON TO A DEPTH OF 4' BELOW GRADE. FOUND THAT THE 1" IRON IS THE MOWING MACHINE AXLE SET BY COBB IN 1893. ALSO FOUND PLOW POINT BY COBB.


ACCEPTED FOUND MOWING MACHINE AXLE AS THE PERPETUATION OF CORNER POSITION BY COBB IN 1893.

REPLACED MOWING MACHINE AXLE WITH STANDARD BARRY COUNTY REMONUMENTATION MONUMENT ACT 345 BARRY COUNTY REMONUMENTATION APPROVED BY PEER REVIEW AT A MEETING HELD ON

4 Oct '94 BRIAN REYNOLDS COUNTY SURVEYOR

C. Description of monument for corner and accessories established to perpetuate locating the position of the corner:

- SET STANDARD BARRY COUNTY REMONUMENTATION MONUMENT (3/4"X36"W/ALUMINUM CAP)
SET 40d NAIL W/REMON TAG IN NORTHWEST SIDE OF A 16" OAK N30E 27.43'
SET 40d NAIL W/REMON TAG IN WEST SIDE OF A 24" OAK S08E 48.27'
SET 40d NAIL W/REMON TAG IN NORTH SIDE OF A UTILITY POLE S60E 35.63'
SET 40d NAIL W/REMON TAG IN NORTH SIDE OF AN 18" APPLE N70W 50.86'
SET 40d NAIL W/REMON TAG IN NORTHEAST SIDE OF A 10" ELM N34W 68.83'
9'+/- EAST OF CENTERLINE BROOK LODGE ROAD
310'+/- SOUTH OF INTERSECTION OF CENTERLINES OF ROADS

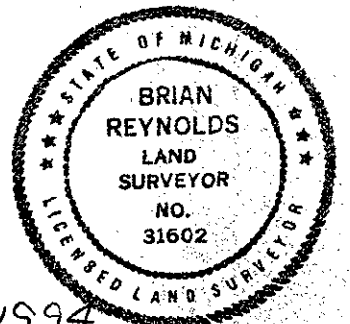

Signed by [Signature] Date Oct 7, 1994
Surveyor's Michigan License No. 31602