

**BARRY COUNTY REMONUMENTATION
LAND CORNER RECORDATION CERTIFICATE
Filing Requirement of Act 74, Mich. P.A. 1970**

SURVEY &
REMONUMENTATION

APR 04 2000

For corners in

BARRY

(County)

BARRY TOWNSHIP

1. Public Land Survey

Located In:

Corner Code #

SECTION

T___ R___
T___ R___
T___ R___
T___ R___
S 3 T 1N R 9W
S___ T___ R___
S___ T___ R___
S___ T___ R___



2800

Page: 1 of 1
12/07/1999 08:36

Darla K. Burghdoff - Barry Co. LCRCR

Register of Deeds Stamp & File Num

2. Property Controlling
in Section

3. Miscellaneous
Property in Sec.

4. Lot No. _____, Recorded Plat _____

5. Private Claims _____

I, ROBERT R. CARR, in a field survey on MAY 7, 1999 do hereby state that under requirements of P.A. 74, Michigan P.A. of 1970, the corner points mentioned in lines 1 and 2 above were in conformance with regulations and rules therefore as required in the current manual of survey instructions of the United States Department of the Interior, Bureau of Land Management or by a decree of a Court of Law and /or that the corner points mentioned in lines 3, 4 and 5 above were in conformance with the rules of the Michigan Board of Land Surveyors or by a Decree of a Court of Law; established, re-established, monumented, recovered, found as expressed below:

NOTE: Not more than 2 corners, all in the same town and range, may be recorded on this certificate.

A. Description of original monument and accessories and/or subsequent restoration:

CENTER OF SECTION NOT SET BY G.L.O.

LEE S. COBB, 1896 FOUND STAKE BY PRATT, SET STONE 20" BY 6" BY 6"

SURVEY BY BRAIN REYNOLDS P.S. NO 31602 IN SE 1/4 SECTION 3, NOV. 23 1992, JOB No 2835

SURVEY BY RAYMOND E. MOORED P.S. No 26463 DATED 6/5/97 JOB NO 97-323

| | A | B | C | D | E | F | G | H | I | J | K | L |
|----|----|---|----|---|---|----|---|----|---|----|---|---|
| 1 | | | | | | | | | | | | |
| 2 | 6 | | 5 | | | 4 | | 3 | | 2 | | 1 |
| 3 | | | | | | | | | | | | |
| 4 | 7 | | 8 | | | 9 | | 10 | | 11 | | 1 |
| 5 | | | | | | | | | | | | |
| 6 | 18 | | 17 | | | 16 | | 15 | | 14 | | 1 |
| 7 | | | | | | | | | | | | |
| 8 | 19 | | 20 | | | 21 | | 22 | | 23 | | 2 |
| 9 | | | | | | | | | | | | |
| 10 | 30 | | 29 | | | 28 | | 27 | | 26 | | 2 |
| 11 | | | | | | | | | | | | |
| 12 | 31 | | 32 | | | 33 | | 34 | | 35 | | 3 |
| 13 | | | | | | | | | | | | |

B. Description of corner evidence found and/or method applied in restoring or reestablishing corner:

STONE BY COBB NOT FOUND.

ESTABLISHED CORNER ON LINE BETWEEN I-2 AND G-2 AND IN LINE WITH LONG STANDING FENCE LINES

RUNNING NORTH AND SOUTH.

THIS LOCATION IS SAME LOCATION AS USED FOR CENTER OF SECTION BY REYNOLDS IN 1992 AND

MOORED IN 1997

**ACT 345 BARRY COUNTY REMONUMENTATION
APPROVED BY PEER REVIEW AT A MEETING HELD ON**

13 SEPT 99

BR

BRIAN REYNOLDS

COUNTY SURVEYOR

C. Description of monument for corner and accessories established to perpetuate locating the position of the corner:

BARRY COUNTY REMONUMENTATION STAKE AND CAP IN MONUMENT BOX

WEST END OF COLVERT (TOP CENTER) ON SOUTH SIDE OF ROAD


S 75°W, 82.22 FT.

SET NAIL AND SPOTTER IN UTILITY POLE, S 01°E, 32.22FT.

SET NAIL AND SPOTTER IN 6" ASH S 59°E, 82.10 FT

SET NAIL AND SPOTTER IN TOP OF 8" WOOD POST N 03°E, 24.72

3' ± NORTH OF CENTERLINE PIFER ROAD

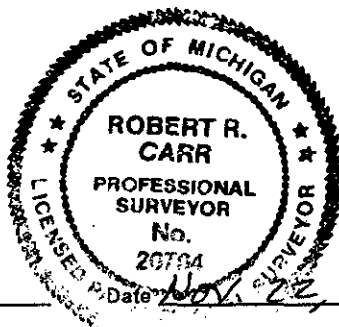

Signed by

[Signature]

Surveyor's Michigan License No. 20704

ROBERT R. CARR