

BARRY COUNTY REMONUMENTATION LAND CORNER RECORDATION CERTIFICATE Filing Requirement of Act 74, Mich. P.A. 1970

APR 04 2000

SECTION

For corners in

BARRY (County)

Located In:

Corner Code #

BARRY TOWNSHIP

1. Public Land Survey

T 1N R 9W

1-2

2. Property Controlling in Section

S T R

3. Miscellaneous

S T R

Property in Sec.

S T R



2798

Page: 1 of 1 12/07/1999 08:36A

Darla K. Burghdoff - Barry Co. LCRCR

Register of Deeds Stamp & File Number

4. Lot No. , Recorded Plat 5. Private Claims

I, ROBERT R. CARR, in a field survey on MAY 7, 1999 do hereby state that under requirements of P.A. 74, Michigan P.A. of 1970, the corner points mentioned in lines 1 and 2 above were in conformance with regulations and rules therefore as required in the current manual of survey instructions of the United States Department of the Interior, Bureau of Land Management or by a decree of a Court of Law and /or that the corner points mentioned in lines 3, 4 and 5 above were in conformance with the rules of the Michigan Board of Land Surveyors or by a Decree of a Court of Law; established, re-established, monumented, recovered, found as expressed below:

NOTE: Not more than 2 corners, all in the same town and range, may be recorded on this certificate.

A. Description of original monument and accessories and/or subsequent restoration:

G.L.O. SYLVESTER SIBLEY, D.S. 1826. PRATT 1888, W.O. 20 S6E .57, MAPLE 6 N2-1/4E .41-1/2 SURVEY BY BRIAN REYNOLDS, NOVEMBER 1992, 1/2" IRON WITH WITNESSES. BARRY COUNTY ROAD COMMISSION, 1996 SET MONUMENT BOX.


B. Description of corner evidence found and/or method applied in restoring or reestablishing corner:

FOUND 1/2" IRON IN MONUMENT BOX PER REYNOLDS SURVEY. OLD FENCE AND TREE ROW RUNNING NORTH. WITH NO OTHER EVIDENCE OF CORNER FOUND, I ACCEPTED THE EXISTING IRON AS THE BEST EVIDENCE OF THE ORIGINAL CORNER.

ACT 345 BARRY COUNTY REMONUMENTATION APPROVED BY PEER REVIEW AT A MEETING HELD ON 13 SEPT 99 BR BRIAN REYNOLDS COUNTY SURVEYOR

C. Description of monument for corner and accessories established to perpetuate locating the position of the corner:

BARRY COUNTY REMONUMENTATION STAKE AND CAP IN MONUMENT BOX UTILITY POLE, S70°W 77.60 FEET, SET BARRY COUNTY SPOTTER 28" OAK, N05°W 45.61 FEET, SET BARRY COUNTY SPOTTER 12" MAPLE, N67°E 97.20 FEET, SET BARRY COUNTY SPOTTER TREE ROW AND OLD FENCE TO NORTH 6' ± WEST OF WEST WALL OF HOUSE #3025 EXTENDED OUT TO ROAD.

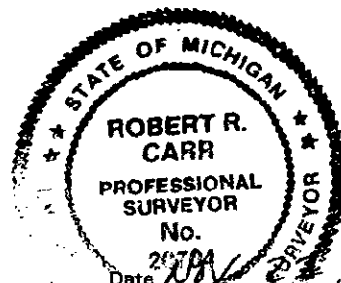

Signed by [Signature]

Surveyor's Michigan License No. 20704 ROBERT R. CARR

Grid table with columns A-L and rows 1-13. Cell (2, H) contains a circled '3'.