

**BARRY COUNTY REMONUMENTATION
LAND CORNER RECORDATION CERTIFICATE
Filing Requirement of Act 74, Mich. P.A. 1970**

For corners in

BARRY Located In: Corner Code #
(County)
BARRY TOWNSHIP
1. Public Land Survey T 1N R 9W 1-3
T _____ R _____
T _____ R _____
T _____ R _____
2. Property Controlling S _____ T _____ R _____
in Section S _____ T _____ R _____
3. Miscellaneous S _____ T _____ R _____
Property in Sec. S _____ T _____ R _____



2804
Page: 1 of 1
12/07/1999 08:36

Darla K. Burghdoff - Barry Co. LCRCR

Register of Deeds Stamp & File Number

4. Lot No. _____, Recorded Plat _____
5. Private Claims _____

I, ROBERT R. CARR, in a field survey on MAY 7, 1999 do hereby state that under requirements of P.A. 74, Michigan P.A. of 1970, the corner points mentioned in lines 1 and 2 above were in conformance with regulations and rules therefore as required in the current manual of survey instructions of the United States Department of the Interior, Bureau of Land Management or by a decree of a Court of Law and /or that the corner points mentioned in lines 3, 4 and 5 above were in conformance with the rules of the Michigan Board of Land Surveyors or by a Decree of a Court of Law; established, re-established, monumented, recovered, found as expressed below:

	A	B	C	D	E	F	G	H	I	J	K	L
1												
2	6		5		4		3		2			1
3									0			
4	7		8		9		10		11			12
5												
6	18		17		16		15		14			13
7												
8	19		20		21		22		23			24
9												
10	30		29		28		27		26			25
11												
12	31		32		33		34		35			3
13												

NOTE: Not more than 2 corners, all in the same town and range, may be recorded on this certificate.

A. Description of original monument and accessories and/or subsequent restoration:

G.L.O.
SURVEY BY BRIAN REYNOLDS, P.S. NO. 31602, NOVEMBER 1992,
2" STEEL PIPE IN EAST-WEST FENCE WITH WITNESSES.

SURVEY &
REMONUMENTATION

APR 04 2000

SECTION


B. Description of corner evidence found and/or method applied in restoring or reestablishing corner:

FOUND PIPE PER REYNOLDS IN REMAINS OF EAST-WEST FENCE.
WITH NO OTHER EVIDENCE OF CORNER FOUND, I ACCEPTED THE FOUND PIPE AS THE BEST EVIDENCE OF THE ORIGINAL CORNER.

**ACT 345 BARRY COUNTY REMONUMENTATION
APPROVED BY PEER REVIEW AT A MEETING HELD ON
13 SEPT 99 RR
BRIAN REYNOLDS COUNTY SURVEYOR**

C. Description of monument for corner and accessories established to perpetuate locating the position of the corner:

SET BARRY COUNTY REMONUMENTATION STAKE AND CAP IN FOUND 2" PIPE
IN REMAINS OF FALLEN EAST-WEST FENCE LINE
5" MAPLE, N86°E 29.30 FEET, SET BARRY COUNTY SPOTTER
3" MAPLE, N01°E 35.61 FEET, SET BARRY COUNTY SPOTTER
4" MAPLE, S88°W 16.51 FEET, SET BARRY COUNTY SPOTTER
5" TAMARACK, S62°W 12.41 FEET, SET BARRY COUNTY SPOTTER.

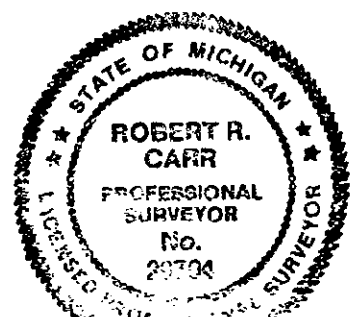

Signed by [Signature]
Surveyor's Michigan License No. 20704 ROBERT R. CARR

Date NOV. 22, 1999