SURVEY & REMONUMENTATION

FEB 17 1998

SECTION

BARRY COUNTY REMONUMENTATION

LAND CORNER RECORDATION CERTIFICATE
Filing Requirement of Act 74, Mich. P.A. 1970

2663
Page: 1 of 1
12/19/1997 07:49A
Sandy Schondelmayer - Barry Co. LCRCR

For Corners in BARRY (county) Located In: Corner Co

1. Public Land Survey ¼ CORNER COMMON TO SECTIONS 14 & 23 BARRY TOWNSHIP — T 1N R 9W — J-7

2. Property Controlling in Section — S___ T___ R___ / S___ T___ R___

3. Miscellaneous Property in Sec. — S___ T___ R___ / S___ T___ R___

Register of Deeds Stamp & File Number

4. Lot No_____, Recorded Plat_____

5. Private Claims_____

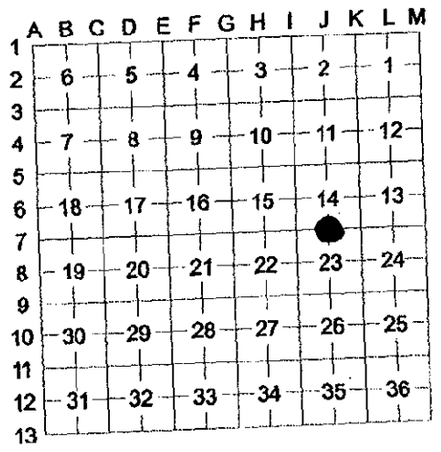

I, **Brian Reynolds**, in a field survey on **10 AUGUST, 1997** do hereby certify that under requirements of P.A. 74, Michigan P.A. of 1970, the corner points mentioned in lines 1 and 2 above were in conformance with regulations and rules therefore as required in the current manual of survey instructions of the United States Department of the Interior, Bureau of Land Management or by a decree of a Court of Law and/or that the corner points mentioned in lines 3, 4, and 5 above were in conformance with the rules of the Michigan Board of Land Surveyors or by a Decree of a Court of Law; established, re-established, monumented, re-monumented, recovered, found as expressed below.

NOTE: Not more than 2 corners, all in the same town and range, may be recorded on this certificate.

A. Description of original monument and accessories and/or subsequent restoration:

1. GENERAL LAND OFFICE: SYLVESTER SIBLEY, D.S., 1826 (R9W,P.18) "WEST CORRECTED 39.72" W. OAK 16 N79E 36 Do. 15 S70W 17
2. COUNTY SURVEYOR RECORDS: FRANK BOWEN, 16 & 17 DEC., 1878 (L.1,P.275) "STAKE & BRICK BY PRATT" (THIS REFERS TO THE 1/8 CORNER BETWEEN I-7 & J-7 SET FOR ROAD CONSTRUCTION P.I.) THE SURVEY BY PRATT IS NOT A SURVEY OF RECORD. PRATT WAS NOT ELECTED COUNTY SURVEYOR UNTIL THE 1880'S.

*** NO OTHER HISTORICAL INFORMATION, PUBLIC OR PRIVATE, AVAILABLE FOR THIS CORNER ***

B. Description of corner evidence found and/or method applied in restoring or reestablishing corner:
FOUND NO MAGNETIC EVIDENCE OF CORNER MONUMENTATION. TRAVERSED THE NORTH ½ OF SECTION 23 & THE SOUTHEAST ¼ OF SECTION 14. BEGAN EXCAVATION AT MID POINT ON LINE BETWEEN I-7 & K-7. 2'+/- SOUTHEAST, AND 0.5'+/- BELOW ROAD GRADE FOUND A STONE 8"x10"x10" SURROUNDED BY A DOZEN 5" STONES SET IN CLAY GRADE. FOUND NO EVIDENCE OF 1/8 CORNER STONE. TIE TO APPROXIMATE ROAD P.I. MEASURES 1307'+/- TO I-7 AND 1313'+/- TO FOUND STONE AT J-7. ACCEPTED FOUND STONE IN RING OF STONES AS BEST EVIDENCE OF CORNER POSITION, PROBABLY AS PERPETUATED BY PRATT. REPLACED STONE WITH STANDARD BARRY COUNTY REMONUMENTATION MONUMENT.

C. Description of monument for corner and accessories established to perpetuate locating the position of the corner:
SET STANDARD BARRY COUNTY REMONUMENTATION MONUMENT (3/4" X 36" IRON) WITH ALUMINUM CAP.
SET 20d NAIL W/PLASTIC TAG IN THE SOUTHWEST ROOT OF A 26" TWIN CHERRY S52°E 24.84'
SET 20d NAIL W/PLASTIC TAG IN THE NORTH ROOT OF A 20" HICKORY S74°E 36.94'
SET 20d NAIL W/PLASTIC TAG IN THE NORTHEAST ROOT OF A 10" OAK N24°E 46.54'
SET 20d NAIL W/PLASTIC TAG IN THE NORTHEAST ROOT OF A 4" HICKORY N46°W 66.15'
SET 20d NAIL W/PLASTIC TAG IN THE SOUTHEAST ROOT OF A 36" HICKORY S72°E 34.46'
IN LINE WITH TREE LINE EAST 4'+/- EAST OF NORTH-SOUTH CENTERLINE
SET ½" CAPPED IRON (REYNOLDS #31602) EAST 33.00'
8'+/- SOUTH OF CENTERLINE WEST

ACT 345 BARRY COUNTY REMONUMENTATION
APPROVED BY PEER REVIEW AT A MEETING HELD ON
13 OCT 97 BR
BRIAN REYNOLDS COUNTY SURVEYOR

STATE OF MICHIGAN
BRIAN REYNOLDS
LAND SURVEYOR
NO. 31602
LICENSED LAND SURVEYOR

Signed by [signature]
Surveyor's Michigan License No 31602

Date Dec 18, 1997

FORM APPROVED BY MICHIGAN STATE BOARD OF LAND SURVEYORS, JAN. 28, 1971
REVISED MAY 14, 1975 REVISED JANUARY, 1983 REVISED OCTOBER 1995