

**SURVEY & REMONUMENTATION**

**BARRY COUNTY REMONUMENTATION**

**FEB 17 1998**

**LAND CORNER RECORDATION CERTIFICATE**  
Filing Requirement of Act 74, Mich. P.A. 1970



**2665**  
Page: 1 of 1  
12/19/1997 07:49A

For Corners in **SECTION BARRY**  
(county)

Located In: Corner Code:

Sandy Schondelmayer - Barry Co. LCRCR

1. Public Land Survey **T 1N R 9W** **K-7**  
CORNER COMMON TO  
SECTIONS 13, 14, 23, & 24  
BARRY TOWNSHIP

2. Property Controlling in Section S T R  
S T R

3. Miscellaneous Property in Sec. S T R  
S T R

4. Lot No. Recorded Plat  
5. Private Claims

Register of Deeds Stamp & File Number

I, **Brian Reynolds**, in a field survey on **18 SEPTEMBER, 1997** do hereby certify that under requirements of P.A. 74, Michigan P.A. of 1970, the corner points mentioned in lines 1 and 2 above were in conformance with regulations and rules therefore as required in the current manual of survey instructions of the United States Department of the Interior, Bureau of Land Management or by a decree of a Court of Law and/or that the corner points mentioned in lines 3, 4, and 5 above were in conformance with the rules of the Michigan Board of Land Surveyors or by a Decree of a Court of Law; established, re-established, monumented, re-monumented, recovered, found as expressed below.

	A	B	C	D	E	F	G	H	I	J	K	L	M
1													
2	6		5		4		3		2		1		
3													
4	7		8		9		10		11		12		
5													
6	18		17		16		15		14		13		
7													
8	19		20		21		22		23		24		
9													
10	30		29		28		27		26		25		
11													
12	31		32		33		34		35		36		
13													

NOTE: Not more than 2 corners, all in the same town and range, may be recorded on this certificate.

A. Description of original monument and accessories and/or subsequent restoration:

- GENERAL LAND OFFICE: SYLVESTER SIBLEY, D.S., 1826 (R9W, P.14) A RED OAK 24 N56E 18 A W. OAK 9 S56W 42
- COUNTY SURVEYOR RECORDS: FRANK BOWEN, 1875 (L.1, P.88) "FOUND OLD BEARING, PUT STONE BRICK & EARTHENWARE FOR CORNER TOOK BEARING: AT PIT FILLED WITH STONES N61 1/2W 38"

\*\*\* NO OTHER INFORMATION, PUBLIC OR PRIVATE, AVAILABLE FOR THIS CORNER \*\*\*


B. Description of corner evidence found and/or method applied in restoring or reestablishing corner:

FOUND SLIGHT MAGNETIC INDICATION ON CENTERLINE OF NORTH-SOUTH GRAVEL ROAD IN LINE WITH FENCE/TREE LINES EAST-WEST. EXCAVATED TO A DEPTH OF 1'+/- AND FOUND PIECES OF BROKEN CHINA AND BROKEN BRICK. FURTHER EXCAVATION REVEALED A LARGE QUANTITY OF BROKEN CHINA, BROKEN CROCKERY, BROKEN GLASS AND BROKEN RED BRICK. AT DEPTH OF 1.5'+/- FOUND THREE 6" STONES AND THREE WHOLE BRICKS SET IN A CIRCLE WITH THE REMAINS OF AN OLD ROTTED WOOD STAKE IN THE CENTER ACCEPTED FOUND STAKE IN CIRCLE OF STONES & BRICKS AS CORNER POSITION BY BOWEN. SET STANDARD BARRY COUNTY REMONUMENTATION MONUMENT IN PLACE OF WOOD STAKE IN THE CENTER OF FOUND BRICKS/STONES.

C. Description of monument for corner and accessories established to perpetuate locating the position of the corner:

SET STANDARD BARRY COUNTY REMONUMENTATION MONUMENT (3/4" X 36" IRON) WITH ALUMINUM CAP.  
SET 20d NAIL W/PLASTIC TAG IN THE WEST ROOT OF AN 18" BLACK WALNUT S40°E 29.49'  
SET 20d NAIL W/PLASTIC TAG IN THE SOUTH ROOT OF A 24" BLACK WALNUT S88°E 49.05'  
SET 20d NAIL W/PLASTIC TAG IN THE SOUTH SDIE OF AN 18" HICKORY S87°W 28.19'  
SET 20d NAIL W/PLASTIC TAG IN THE SOUTHEAST SIDE OF A 9" HICKORY S29°W 53.20'  
NORTHWEST CORNER OF A 3'+ "SQUARE" BOULDER N16°E 77.86'  
1.5'+/- EAST OF NORTH-SOUTH GRAVEL CENTERLINE  
IN LINE WITH TREE LINES EAST-WEST

ACT 345 BARRY COUNTY REMONUMENTATION  
APPROVED BY PEER REVIEW AT A MEETING HELD ON  
13 Oct. 97  
BRIAN REYNOLDS  
COUNTY SURVEYOR

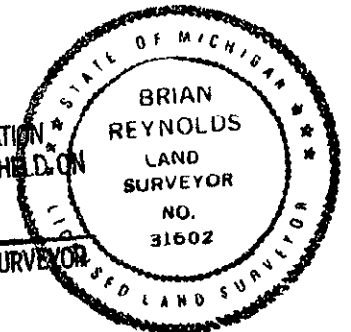

Signed by Brian Reynolds  
Surveyor's Michigan License No 31602

Date DEC 18, 1997