

FEB 17 1998

SECTION

BARRY COUNTY REMONUMENTATION

LAND CORNER RECORDATION CERTIFICATE
Filing Requirement of Act 74, Mich. P.A. 1970

For Corners in
BARRY
(county)

Located In:

Corner Code:



2666
Page: 1 of 1
12/19/1997 07:49A

Sandy Schonhelmayer - Barry Co. LCRCR

- 1. Public Land Survey T 1N R 9W K-8
 1/4 CORNER COMMON TO T R
 SECTIONS 23 & 24 T R
 BARRY TOWNSHIP T R
- 2. Property Controlling S T R
 in Section S T R
- 3. Miscellaneous S T R
 Property in Sec. S T R
- 4. Lot No: _____, Recorded Plat _____
- 5. Private Claims _____

Register of Deeds Stamp & File Number

I, **Brian Reynolds**, in a field survey on **25 SEPTEMBER, 1997** do hereby certify that under requirements of P.A. 74, Michigan P.A. of 1970, the corner points mentioned in lines 1 and 2 above were in conformance with regulations and rules therefore as required in the current manual of survey instructions of the United States Department of the Interior, Bureau of Land Management or by a decree of a Court of Law and/or that the corner points mentioned in lines 3, 4, and 5 above were in conformance with the rules of the Michigan Board of Land Surveyors or by a Decree of a Court of Law; established, re-established, monumented, re-monumented, recovered, found as expressed below.

NOTE: Not more than 2 corners, all in the same town and range, may be recorded on this certificate.

A. Description of original monument and accessories and/or subsequent restoration:

- 1. GENERAL LAND OFFICE: SYLVESTER SIBLEY, D.S., 1826 (R9W, P.14) A W. OAK 10 S75E 13 Do. 7 S64W 29
- 2. COUNTY SURVEYOR RECORDS: FRANK BOWEN, 17 APRIL 1878 (L.1, P.238) "STAKE AND LARGE STONE FOR CORNER" "FOUND OLD CORNER STONE & ROOTS OF BEARING TREES. STONE WITH "W I L" CUT ON IT"
 B. O. 6 N61W 53 1/2 HICK 6 S62W 61
- 3. UNRECORDED SURVEY: BY RAYMOND MOORED, P.S. #26463, 12-5-96, "FOUND IRON" NO WITNESSES GIVEN

B. Description of corner evidence found and/or method applied in restoring or reestablishing corner:


FOUND 20d NAIL AT APPROXIMATE CENTERLINE OF EAST-WEST GRAVEL ROAD IN LINE WITH FENCE/TREE LINE SOUTH. TRAVERSE OF THE NORTH 1/2 OF SECTION 23 CONFIRMS NAIL AS POSITION RECITED BY MOORED SURVEY. FOUND HICKORY BEARING TREE BY BOWEN (ITEM #2 ABOVE). EXCAVATED AT BEARING AND DISTANCE FROM HICKORY AS PER BOWEN'S SURVEY. AT A DEPTH OF 2.5'+/- FOUND BITS OF BRICK AND OLD ROTTEN WOOD STAKE. DIRECTLY NEXT TO AND AT BOTTOM OF WOOD STAKE FOUND A 7"x 7"x4" OBLONG STONE WITH "W I L" CUT INTO IT, AS REFERED TO BY BOWEN'S SURVEY. EXCAVATED ANOTHER 1 FOOT+/- AND PROBED THROUGH SAND AN ADDITIONAL 2 FEET +/-, DID NOT FIND LARGE STONE REFERRED TO BY BOWEN. WE CLEANED THE FOUND STONE AND ON THE REVERSE SIDE FOUND "1/4 P. 23.4" CUT INTO IT. ACCEPTED FOUND STONE AND ROTTED WOOD STAKE AS CORNER POSITION RECITED BY BOWEN. DISREGARDED FOUND 20d NAIL. SET STANDARD BARRY COUNTY REMONUMENTATION MONUMENT IN PLACE OF FOUND STONE AND WOOD STAKE.

C. Description of monument for corner and accessories established to perpetuate locating the position of the corner:

- SET 3/4" X 24" IRON UNDER A 3/4" X 24" IRON WITH ALUMINUM REMONUMENTATION CAP.
- SET CHISELED "X" WITH DRILL HOLE IN THE TOP OF A LARGE GRANITE BOULDER SOUTH 38.95'
- SET 20d NAIL W/PLASTIC TAG IN THE NORTH SIDE OF A 32" HICKORY S64°W 40.25'
- SET 20d NAIL W/PLASTIC TAG IN THE NORTHEAST SIDE OF A 14" WALNUT S42°E 46.98'
- SET 20d NAIL W/PLASTIC TAG IN THE NORTH ROOT OF A 16" WALNUT S54°E 76.22'
- SET 20d NAIL W/PLASTIC TAG IN THE SOUTH ROOT OF AN 18" BLACK OAK N66°E 53.91'
- 3'+/- NORTH OF GRAVEL CENTERLINE EAST-WEST (LEINAAR ROAD)
- 44'+/- EAST OF GRAVEL CENTERLINE NORTH (GURD ROAD)
- IN LINE WITH TREE/FENCE LINE SOUTH

	A	B	C	D	E	F	G	H	I	J	K	L	M
1													
2	6		5		4		3		2		1		
3													
4	7		8		9		10		11		12		
5													
6	18		17		16		15		14		13		
7													
8	19		20		21		22		23		24		
9													
10	30		29		28		27		26		25		
11													
12	31		32		33		34		35		36		
13													

ACT 345 BARRY COUNTY REMONUMENTATION
APPROVED BY PEER REVIEW AT A MEETING HELD ON
13 Oct '97 BR
BRIAN REYNOLDS COUNTY SURVEYOR

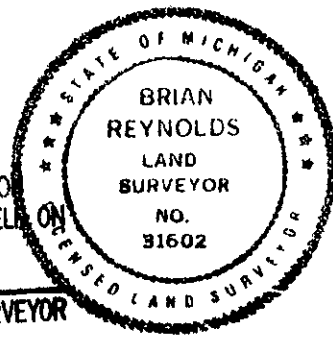

Signed by [Signature]
Surveyor's Michigan License No 31602

Date DEC 18, 1997