

FEB 17 1998

BARRY COUNTY REMONUMENTATION

LAND CORNER RECORDATION CERTIFICATE
Filing Requirement of Act 74, Mich. P.A. 1970

SECTION

For Corners in

BARRY

(county)

Located In:

Corner Code #



2606

Page: 1 of 1
09/16/1997 11:48A

- 1. Public Land Survey T 1N R 10W A-9
CORNER COMMON TO T R
SECTIONS 19 & 30 T R
PRAIRIEVILLE TOWNSHIP T R
ON RANGE LINE
- 2. Property Controlling S T R
in Section S T R
- 3. Miscellaneous S T R
Property in Sec. S T R
- 4. Lot No , Recorded Plat
- 5. Private Claims

Sandy Schondelmayer - Barry Co. LCRCR

Register of Deeds Stamp & File Number

I, Brian Reynolds, in a field survey on 10 JULY, 1997 do hereby certify that under requirements of P.A. 74, Michigan P.A. of 1970, the corner points mentioned in lines 1 and 2 above were in conformance with regulations and rules therefore as required in the current manual of survey instructions of the United States Department of the Interior, Bureau of Land Management or by a decree of a Court of Law and/or that the corner points mentioned in lines 3, 4, and 5 above were in conformance with the rules of the Michigan Board of Land Surveyors or by a Decree of a Court of Law; established, re-established, monumented, re-monumented, recovered, found as expressed below.

	A	B	C	D	E	F	G	H	I	J	K	L	M
2	6	5	4	3	2	1							
3													
4	7	8	9	10	11	12							
5													
6	18	17	16	15	14	13							
7													
8	19	20	21	22	23	24							
9													
10	30	29	28	27	26	25							
11													
12	31	32	33	34	35	36							
13													

NOTE: Not more than 2 corners, all in the same town and range, may be recorded on this certificate.

A. Description of original monument and accessories and/or subsequent restoration:

1. GENERAL LAND OFFICE: SYLVESTER SIBLEY, D.S., 1826 (R10W, P.32) "WEST 82.39 INTERSECTED W. BOUNDARY 46 N. OF POST" A TAMARACK 7 N21W 33 A. B. ASH 8 S35E 44
2. GENERAL LAND OFFICE: SYLVESTER SIBLEY, D.S., 1826 (R11W, P.10 FOR M-9, T1N, R11W, ALLEGAN COUNTY RECORDS) "80.00 SET POST CORNER TO SECTIONS 24 & 25" TAMARACK 6 N18 1/2W 26 Do. 6 S23 1/2W 27
3. BARRY COUNTY SURVEYOR RECORDS: JOHN CRESSY, OCT. 9, 1884 (L.2,P.244) "FOUND OLD BEARINGS & POST, PUT IN TILE, TOOK NEW BEARINGS" W. WOOD 13 S60E 3.24 B. ASH 6 N46 1/2E 61
4. PLAT OF SHANGRI-LA NUMBER TWO, BY WENLEY Q. SMITH, P.S. #6528, 24 DEC., 1968 (L. 5 OF PLATS, P.7) REFERENCED, NO WITNESSES.
5. BARRY COUNTY ROAD COMMISSION: NO NAME, AUG 17, 1972, "CONC. MONU" 3" ASH N10°W 21.0' WILLOW CLUMP S85°W 27.0' TO C/L PLAT MONU. N17.5'
6. LAND CORNER RECORDATION CERTIFICATE: #39, BY DENNIS A. MIDDLETON, P.S. #16049, 20 SEPT., 1972 "FOUND PLAT MONUMENT" WITNESSES SAME AS IN #3 ABOVE.
7. ACT 132 SURVEYS BY DENNIS A. MIDDLETON, P.S. #16049, (L.1,P.51, 9-20-72) & (L.1,P.62-65, 12-6-72) RECITE SAME WITNESSES AS IN #3 ABOVE.

B. Description of corner evidence found and/or method applied in restoring or reestablishing corner:

FOUND 4" ROUND CONCRETE PLAT MONUMENT WITH 1/2" IRON IN CENTER. FOUND WILLOW AND PLAT MONUMENT WITNESSES AS RECITED IN #4, #5, #6, & #7 ABOVE. FOUND M-9, T1N, R11W (FOUND 2" PIPE FILLED WITH CONCRETE IN LAKE DOSTER) AND PLAT MONUMENT NORTH, CONFORM WITH RECORDED DISTANCES. CORNER LIES 0.10 FEET WEST OF RANGE LINE. ACCEPTED FOUND PLAT MONUMENT AS CORNER POSITION BY SMITH. LEFT FOUND 4" ROUND PLAT MONUMENT WITH 1/2" IRON IN PLACE.

C. Description of monument for corner and accessories established to perpetuate locating the position of the corner:

4" ROUND CONCRETE PLAT MONUMENT WITH 1/2" IRON IN CENTER
M-9, T1N, R10W (2 1/2" PIPE FILLED WITH CONCRETE) LIES S00°14'14"W 30.33'
FOUND "PK" IN THE SOUTH SIDE OF AN 18" WILLOW N82°W 19.76'
FOUND "PK" IN THE NORTH SIDE OF A 12" ASH S80°E 47.73'
FOUND "PK" IN THE WEST SIDE OF A 4" ASH N36°W 11.76'
CONCRETE PLAT MONUMENT LIES N01°07'21"W 17.82'
LAKE SHORE LIES SOUTH 16'+/-


ACT 345 BARRY COUNTY REMONUMENTATION
APPROVED BY PEER REVIEW AT A MEETING HELD ON

8 SEPT. '97

BRIAN REYNOLDS

BR

COUNTY SURVEYOR

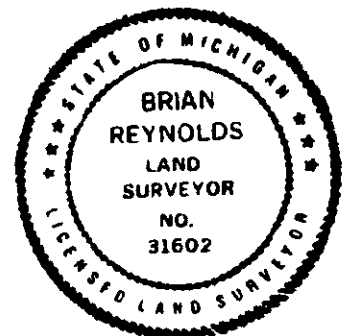

Signed by

Brian Reynolds

Surveyor's Michigan License No 31602

Date

9/10/97