

**SURVEY & REMONUMENTATION**

1993

**COMMISSION**

**BARRY COUNTY REMONUMENTATION  
LAND CORNER RECORDATION CERTIFICATE  
Filing Requirement of Act 74, Mich. P.A. 1970**

STATE OF MICHIGAN  
COUNTY OF BARRY  
RECEIVED FOR RECORD

JUL 12 12 50 PM '93

Sandy Schindelmarjer  
REGISTER OF DEEDS

**002019**

Register of Deeds Stamp & File Number

For corners in  
BARRY

(County)

Located in:

Corner Code #

- |                                       |                            |                             |
|---------------------------------------|----------------------------|-----------------------------|
| 1. Public Land Survey                 | T <u>1</u> N R <u>10</u> W | D-11 (N $\frac{1}{2}$ , 32) |
|                                       | T _____ R _____            | Prairieville                |
|                                       | T _____ R _____            | _____                       |
|                                       | T _____ R _____            | _____                       |
| 2. Property Controlling<br>in Section | S _____ T _____ R _____    | _____                       |
|                                       | S _____ T _____ R _____    | _____                       |
| 3. Miscellaneous<br>Property in Sec.  | S _____ T _____ R _____    | _____                       |
|                                       | S _____ T _____ R _____    | _____                       |

4. Lot No. \_\_\_\_\_, Recorded Plat \_\_\_\_\_  
5. Private Claims \_\_\_\_\_

	A	B	C	D	E	F	G	H	I	J	K	L	M
2	6	5	4	3	2	1							
3													
4	7	8	9	10	11	12							
5													
6	18	17	16	15	14	13							
7													
8	19	20	21	22	23	24							
9													
10	30	29	28	27	26	25							
11													
12	31	32	33	34	35	36							
13													

I, David F. Peabody in a field survey on May, 19 93, do hereby certify that under requirements of P.A. 74, Michigan P.A. of 1970, the corner points mentioned in lines 1 and 2 above were in conformance with regulations and rules therefore as required in the current manual of survey instructions of the United States Department of the Interior, Bureau of Land Management or by a decree of a Court of Law and/or that the corner points mentioned in lines 3, 4 and 5 above were in conformance with the rules of the Michigan Board of Land Surveyors or by a Decree of a Court of Law; established, re-established, monumented, re-monumented, recovered, found as expressed below:


**NOTE: Not more than 4 corners, all in the same town and range, may be recorded on this certificate.**

A. Description of original monument and accessories and/or subsequent restoration:

- G.L.O.: Consumers Power Company 1965 ±  
 B. Oak 26 N61E 75 Found 3" Drain Tile  
 W. Oak 9 S32W 67 20" Tw. W. Cherry N35E 10.15'  
 18" W. Cherry East 9.35'  
 Resurvey By Cressy (Deputy Surveyor) 1884 2" S. of E&W Fence  
 Found Old Stake & Stone (Put in Tile) in Fence South  
 B. Oak 10 N87W 128  
 Hickory 6 N26E 14

B. Description of corner evidence found and/or method applied in restoring or reestablishing corner:

- Found 3" Tile  
 Per Consumers Power Company Witnesses Above (All)

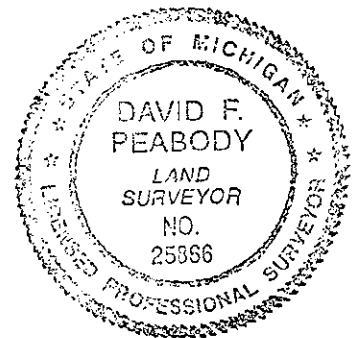

C. Description of monument for corner and accessories established to perpetuate locating the position of the corner:

- Set 3/4" Iron W/Remon Cap in Center of Tile  
 2'± S. of E&W Fence  
 in Fence South  
 20d Nail W/Barry Co. Tag N. Side 8" Oak W. 4.48'  
 20d Nail W/Barry Co. Tag N. Side 8" Oak S62°W 11.77'  
 20d Nail W/Barry Co. Tag W. Side 10" Triple W. Cherry S. 39.80'  
 20d Nail W/Barry Co. Tag SW Side 8" Oak N60°W 58.06'

Signed by David F. Peabody Date 6/18/93  
 Surveyor's Michigan License No. 25866