

**SURVEY & REMONUMENTATION**

1993

**COMMISSION**

**BARRY COUNTY REMONUMENTATION  
LAND CORNER RECORDATION CERTIFICATE  
Filing Requirement of Act 74, Mich. P.A. 1970**

STATE OF MICHIGAN  
COUNTY OF BARRY  
RECEIVED FOR RECORD

JUL 12 12 50 PM '93

Sandy Schondelmarer  
REGISTER OF DEEDS

For corners in

BARRY

(County)

Located In:

Corner Code #

- |                                    |              |               |                             |
|------------------------------------|--------------|---------------|-----------------------------|
| 1. Public Land Survey              | T <u>1</u> N | R <u>10</u> W | D-13 (S $\frac{1}{4}$ , 32) |
|                                    | T _____      | R _____       | Prairieville                |
|                                    | T _____      | R _____       |                             |
|                                    | T _____      | R _____       |                             |
| 2. Property Controlling in Section | S _____      | T _____       | R _____                     |
|                                    | S _____      | T _____       | R _____                     |
| 3. Miscellaneous Property in Sec.  | S _____      | T _____       | R _____                     |
|                                    | S _____      | T _____       | R _____                     |

002020

Register of Deeds Stamp & File Number

4. Lot No. \_\_\_\_\_, Recorded Plat \_\_\_\_\_  
5. Private Claims \_\_\_\_\_

	A	B	C	D	E	F	G	H	I	J	K	L	I
2	6		5		4		3		2		1		
3													
4	7		8		9		10		11		12		
5													
6	18		17		16		15		14		13		
7													
8	19		20		21		22		23		24		
9													
10	30		29		28		27		26		25		
11													
12	31		32		33		34		35		36		
13													

I, David F. Peabody in a field survey on May, 19 93, do hereby certify that under requirements of P.A. 74, Michigan P.A. of 1970, the corner points mentioned in lines 1 and 2 above were in conformance with regulations and rules therefore as required in the current manual of survey instructions of the United States Department of the Interior, Bureau of Land Management or by a decree of a Court of Law and/or that the corner points mentioned in lines 3, 4 and 5 above were in conformance with the rules of the Michigan Board of Land Surveyors or by a Decree of a Court of Law; established, re-established, monumented, re-monumented, recovered, found as expressed below:

**NOTE: Not more than 4 corners, all in the same town and range, may be recorded on this certificate.**

A. Description of original monument and accessories and/or subsequent restoration:

G.L.O.:

W. Oak 7 N11W 151

Do. 16 N58E 196

Resurvey By Cressy (Deputy Surveyor) 1884

Found Post (Put in Tile)

Hickory 10 N61W 4

W.O. 6 N1 $\frac{1}{2}$ W 10

Consumers Power Company 1965±

Found Tile

40" Oak W. 27.3'

30" Hickory N9 $\frac{1}{2}$ W 161.00'


1' S. of E&W Fence

102' E. of Fence South

B. Description of corner evidence found and/or method applied in restoring or reestablishing corner:

Found Tile W/1/2" Rerod

Fit Consumers Power Company Witnesses Above (All)

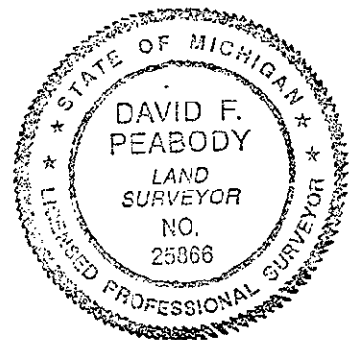

C. Description of monument for corner and accessories established to perpetuate locating the position of the corner:

Replaced 1/2" Rerod W/3/4" Iron W/Remon Cap in Center of Tile

1'± S. of E&W Fence

102'± E. of Fence South

20d Nail W/Barry Co. Tag E. Side 8" W. Cherry N27°W 5.92'

20d Nail W/Barry Co. Tag NW Side 10" Twin Elm N45°E 4.30'

20d Nail W/Barry Co. Tag N. Side 6" W. Cherry E. 1.74'

20d Nail W/Barry Co. Tag W. Side 6" W. Cherry S17°W 5.94'

Signed by David F. Peabody

Date 6/18/93

Surveyor's Michigan License No. 25866