

SURVEY & REMONUMENTATION

1993

COMMISSION

**BARRY COUNTY REMONUMENTATION
LAND CORNER RECORDATION CERTIFICATE
Filing Requirement of Act 74, Mich. P.A. 1970**

STATE OF MICHIGAN
COUNTY OF BARRY
RECEIVED FOR RECORD

JUL 20 11 21 AM '93

Sandy Schondelmayer
REGISTER OF DEEDS

002025

Register of Deeds Stamp & File Number

For corners in

<u>BARRY</u> (County)	Located In:	Corner Code #
1. Public Land Survey	T <u>IN</u> R <u>10W</u>	<u>E-4</u> <u>PRAIRIEVILLE</u>
	T _____ R _____	_____
	T _____ R _____	_____
	T _____ R _____	_____
2. Property Controlling in Section	S _____ T _____ R _____	_____
	S _____ T _____ R _____	_____
3. Miscellaneous Property in Sec.	S _____ T _____ R _____	_____
	S _____ T _____ R _____	_____

4. Lot No. _____, Recorded Plat _____
5. Private Claims _____

I, BRIAN REYNOLDS, in a field survey on JULY, 19 93, do hereby certify that under requirements of P.A. 74, Michigan P.A. of 1970, the corner points mentioned in lines 1 and 2 above were in conformance with regulations and rules therefore as required in the current manual of survey instructions of the United States Department of the Interior, Bureau of Land Management or by a decree of a Court of Law and/or that the corner points mentioned in lines 3, 4 and 5 above were in conformance with the rules of the Michigan Board of Land Surveyors or by a Decree of a Court of Law; established, re-established, monumented, re-monumented, recovered, found as expressed below:

A	B	C	D	E	F	G	H	I	J	K	L	A
2	6	5	4	3	2	1						
3												
4	7	8	9	10	11	12						
5												
6	18	17	16	15	14	13						
7												
8	19	20	21	22	23	24						
9												
10	30	29	28	27	26	25						
11												
12	31	32	33	34	35	36						
13												

NOTE: Not more than 4 corners, all in the same town and range, may be recorded on this certificate.

A. Description of original monument and accessories and/or subsequent restoration:

CORNER ESTABLISHED BY GENERAL LAND OFFICE DEPUTY SURVEYOR SYLVESTER SIBLEY UNDER CONTRACT DATED 5TH OCT 1826. SET POST. A W. OAK 20 S47E 26
A Y. OAK 18 N6E 22

TOWNSHIP RESURVEY BY CRESSY (1884) 1/4 CORNER BETWEEN 8 & 9, FOUND OLD POST & BEARINGS, PUT IN TILE & TOOK NEW
B OAK 10 S41 1/2 W 26
APPLE 8 N19 1/2 W 47
LCRC #434

L.C.R.C #434 (CARR) 1988 FOUND 3" HOLLOW CLAY TILE
30" OAK S. 36.86'
16" HICKORY S60°E, 44.0'
10" CHERRY N50°E, 31.40'
R.R. TIE POST N2°W, 6.0'

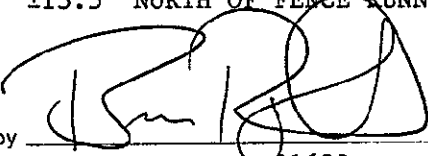
B. Description of corner evidence found and/or method applied in restoring or reestablishing corner:

FOUND 1/2" IRON IN CENTER OF 3" TILE AS DESCRIBED IN L.C.R.C. #434.
ALL WITNESSES PRESENT AND CORRECT.
ACCEPTED THE POSITION OF THE TILE AS A CAREFUL AND FAITHFUL PERPETUATION OF THE CORNER POSITION AS PERPETUATED BY CRESSY AND CARR.

C. Description of monument for corner and accessories established to perpetuate locating the position of the corner:

REPLACED 1/2" IRON WITH STANDARD 3/4" REMONUMENTATION IRON AND ALUMINUM CAP.

40D NAIL AND WITNESS TAG IN EAST SIDE OF 5" SASSAFRASS N02°W 12.99'
40D NAIL AND WITNESS TAG IN EAST SIDE OF 12" HICKORY N25°E 55.00'
40D NAIL AND WITNESS TAG IN WEST SIDE OF RR TIE FENCE CORNER SOUTH 13.49'
IN NORTH-SOUTH FENCE
±13.5' NORTH OF FENCE RUNNING EAST

Signed by 

Date JULY 19, 1993

Surveyor's Michigan License No. 31602

