

**SURVEY & REMONUMENTATION**

JUL 24 1997

COMMISSION

**BARRY COUNTY REMONUMENTATION**

LAND CORNER RECORDATION CERTIFICATE  
Filing Requirement of Act 74, Mich. P.A. 1970

STATE OF MICHIGAN  
COUNTY OF BARRY  
REGISTER OF DEEDS

MAR 5 9 26 AM '97

Samuel J. [unclear]  
REGISTER OF DEEDS

002488

Register of Deeds Stamp & File Number

For corners in **BARRY**  
(County)

Located In: Corner Code #

1. Public Land Survey  
1/4 CORNER COMMON TO  
SECTIONS 28 & 29  
PRAIRIEVILLE TOWNSHIP

T 1N R 10W E-10

2. Property Controlling  
in Section

S \_\_\_\_\_ T \_\_\_\_\_ R \_\_\_\_\_

3. Miscellaneous  
Property in Sec.

S \_\_\_\_\_ T \_\_\_\_\_ R \_\_\_\_\_

4. Lot No. \_\_\_\_\_, Recorded Plat \_\_\_\_\_  
5. Private Claims \_\_\_\_\_

	A	B	C	D	E	F	G	H	I	J	K	L	M
2	6		5		4		3		2		1		
3													
4	7		8		9		10		11		12		
5													
6	18		17		16		15		14		13		
7													
8	19		20		21		22		23		24		
9													
10	30		29		28		27		26		25		
11													
12	31		32		33		34		35		36		
13													

**BRIAN REYNOLDS** 27 JUNE 1996

I, BRIAN REYNOLDS in a field survey on 27 JUNE 1996  
do hereby certify that under requirements of P.A. 74, Michigan P.A. of 1970, the corner points mentioned in lines 1 and 2 above were in conformance with regulations and rules therefore as required in the current manual of survey instructions of the United States Department of the Interior, Bureau of Land Management or by a decree of a Court of Law and/or that the corner points mentioned in lines 3, 4 and 5 above were in conformance with the rules of the Michigan Board of Land Surveyors or by a Decree of a Court of Law; established, re-established, monumented, re-monumented, recovered, found as expressed below:

NOTE: Not more than 4 corners, all in the same town and range, may be recorded on this certificate.

A. Description of original monument and accessories and/or subsequent restoration:

1. GENERAL LAND OFFICE: SYLVESTER SIBLEY, D.S., 1826 (R10W,P.27) A. W. OAK 22 N27 1/2W 81 Do. 40 N33E 79
2. COUNTY SURVEYOR RECORDS: CRESSY, OCT-NOV, 1884 (L.2, P.255) "FOUND OLD STAKE & STONE, PUT IN TILE" B. OAK 6 N81W 22 NO OTHER TIMBER NEAR

NO OTHER RECORDED HISTORICAL INFORMATION AVAILABLE FOR THIS CORNER

B. Description of corner evidence found and/or method applied in restoring or reestablishing corner:


FOUND 3" HOLLOW CORE TILE IN A NORTH AND SOUTH DECAYING FENCE, IN LINE WITH A TREE/FENCE LINE RUNNING WEST. DISTANCES TO FOUND TILE AT E-9 & FOUND 1/2" CAPPED IRON AT E-11 (RESET FROM OLD WITNESSES BY RAY MOORED P.S.#26463) COMPARE VERY WELL WITH DISTANCES RECORDED BY CRESSY (#2, PART "A").

ACCEPTED FOUND TILE AS TRUE CORNER POSITION PERPETUATED BY CRESSY.

PLACED STANDARD BARRY COUNTY REMONUMENTATION MONUMENT INSIDE OF FOUND TILE.

ACT 345 BARRY COUNTY REMONUMENTATION  
APPROVED BY PEER REVIEW AT A MEETING HELD ON

7-8-96  
BRIAN REYNOLDS COUNTY SURVEYOR

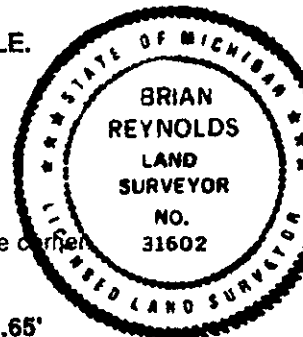

C. Description of monument for corner and accessories established to perpetuate locating the position of the corner:

- SET STANDARD BARRY COUNTY REMONUMENTATION MONUMENT (WITH ALUMINUM CAP)
- SET 20d NAIL W/REMON TAG IN THE NORTHEAST SIDE OF A WOODEN FENCE POST SOUTH 0.65'
- SET 20d NAIL W/REMON TAG IN THE SOUTHWEST SIDE OF A 14" OAK N22°W 3.84'
- SET 20d NAIL W/REMON TAG IN THE WEST SIDE OF A 12" APPLE N1°E 7.23'
- SET 20d NAIL W/REMON TAG IN THE WEST ROOT OF A 14" CHERRY S11°W 5.19'
- SET 20d NAIL W/REMON TAG IN THE SOUTH SIDE OF A 4" CHERRY N88°E 21.40'
- CORNER LIES IN A DECAYING NORTH-SOUTH FENCE IN LINE WITH TREE/FENCE LINE RUNNING WEST

Signed by

Date FEB 18 1997