

SURVEY & REMONUMENTATION

BARRY COUNTY REMONUMENTATION

JUL 24 1997

LAND CORNER RECORDATION CERTIFICATE
Filing Requirement of Act 74, Mich. P.A. 1970

COMMISSION

For Corners in BARRY Located In: _____ Corner Code # _____
(county)

1. Public Land Survey T 1N R 10W _____ F-9 _____
1/4 CORNER COMMON TO T _____ R _____
SECTIONS 21 & 28 T _____ R _____
PRAIRIEVILLE TOWNSHIP T _____ R _____

2. Property Controlling S _____ T _____ R _____
in Section S _____ T _____ R _____

3. Miscellaneous S _____ T _____ R _____
Property in Sec. S _____ T _____ R _____

4. Lot No _____, Recorded Plat _____

5. Private Claims _____

STATE OF MICHIGAN
BARRY COUNTY
RECORDED

17 JUN 97 12:22 P.M.

SANDY SCHONDELMAYER
REGISTER OF DEEDS

002514

Register of Deeds Stamp & File Number

I, **Brian Reynolds**, in a field survey on **12 NOVEMBER, 1996** do hereby certify that under requirements of P.A. 74, Michigan P.A. of 1970, the corner points mentioned in lines 1 and 2 above were in conformance with regulations and rules therefore as required in the current manual of survey instructions of the United States Department of the Interior, Bureau of Land Management or by a decree of a Court of Law and/or that the corner points mentioned in lines 3, 4, and 5 above were in conformance with the rules of the Michigan Board of Land Surveyors or by a Decree of a Court of Law; established, re-established, monumented, re-monumented, recovered, found as expressed below.

	A	B	C	D	E	F	G	H	I	J	K	L	M
2	6	5	4	3	2	1							
3													
4	7	8	9	10	11	12							
5													
6	18	17	16	15	14	13							
7													
8	19	20	21	22	23	24							
9													
10	30	29	28	27	26	25							
11													
12	31	32	33	34	35	36							
13													

NOTE: Not more than 2 corners, all in the same town and range, may be recorded on this certificate.

A. Description of original monument and accessories and/or subsequent restoration:

- GENERAL LAND OFFICE: SYLVESTER SIBLEY, D.S., 1826 (R10W, P.27) WEST CORRECTED 40.17
A HICKORY 6 S60E 136 Do. 5 N16W 125
- COUNTY SURVEYOR RECORDS: CRESSY, OCT.-NOV., 1884 (L.2, P.255 RESURVEY) "PUT IN TILE ON TRUE LINE. NO TIMBER NEAR"

NO OTHER INFORMATION, PUBLIC OR PRIVATE, AVAILABLE FOR THIS CORNER

B. Description of corner evidence found and/or method applied in restoring or reestablishing corner:

PRELIMINARY EXCAVATION REVEALED NO EVIDENCE OF CORNER MONUMENTATION. CORNER POSITION IS IN THE EDGE OF A WORKING FARM FIELD JUST NORTH OF AN OLD FARM LANE BETWEEN TWO FIELDS. BELIEVE CORNER TO HAVE BEEN PLOWED OUT BY FARM EQUIPMENT. AFTER TRAVERSE OF SECTION 28 TYING IN FOUND TILES BY CRESSY AT E-9, E-10, F-11, G-10, G-11, REESTABLISHED G-9, ANCIENT OCCUPATION AT G-8, AND OCCUPATION THROUGHOUT SECTION, COMPUTED POSITION FOR F-9 AT MID POINT AND ON LINE BETWEEN E-9 & G-9. SECOND EXCAVATION REVEALED NO EVIDENCE. THIS METHOD WAS CONSISTENT WITH RECORDED DISTANCES BY CRESSY (ITEM #2 OF PART "A") AND FITS EXCEPTIONALLY WELL WITH OCCUPATION THROUGHOUT SECTION.
ACCEPTED MID POINT ON LINE AS A PROPER RESTORATION OF CORNER POSITION BY CRESSY.
SET STANDARD BARRY COUNTY REMONUMENTATION MONUMENT.


C. Description of monument for corner and accessories established to perpetuate locating the position of the corner:

SET STANDARD BARRY COUNTY REMONUMENTATION MONUMENT (WITH ALUMINUM CAP)
NO TIMBER NEAR CORNER
SET 1/2" CAPPED IRON (REYNOLDS 31602) S45°E 30.00'
SET 1/2" CAPPED IRON (REYNOLDS 31602) S45°W 30.00'
SET "T" FENCE POST 1' NORTH OF 1/4 CORNER
CENTERLINE OF ON OLD FARM TRAIL RUNNING EAST AND WEST LIES SOUTH 12'+/-
E-9 LIES N89°37'24"W 2666.67' G-9 LIES S89°37'24"E 2666.67'

ACT 345 BARRY COUNTY REMONUMENTATION
APPROVED BY PEER REVIEW AT A MEETING HELD ON

7-8-96
BRIAN REYNOLDS

BR
COUNTY SURVEYOR

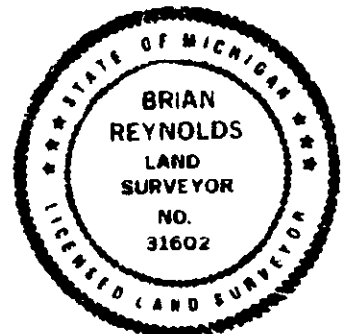

Signed by Brian Reynolds

Date MAY 16, 1997