

SURVEY & REMONUMENTATION

BARRY COUNTY REMONUMENTATION

SEP 14 1999

LAND CORNER RECORDATION CERTIFICATE
Filing Requirement of Act 74, Mich. P.A. 1970

STATE OF MICHIGAN
BARRY COUNTY
RECORDED

SECTION

For Corners in <u>BARRY</u> (county)	Located In:	Corner Code #
1. Public Land Survey CENTER OF SECTION 28 PRAIRIEVILLE TOWNSHIP	T <u>1N</u> R <u>10W</u> T _____ R _____ T _____ R _____ T _____ R _____	<u>F-10</u> _____ _____ _____
2. Property Controlling in Section	S _____ T _____ R _____ S _____ T _____ R _____	_____ _____
3. Miscellaneous Property in Sec.	S _____ T _____ R _____ S _____ T _____ R _____	_____ _____
4. Lot No _____, Recorded Plat _____		
5. Private Claims _____		

17 JUN 97 12:23 P.M.

SANDY SCHONDELMAYER
REGISTER OF DEEDS

002516

Register of Deeds Stamp & File Number

I, **Brian Reynolds**, in a field survey on **5 AUGUST, 1996** do hereby certify that under requirements of P.A. 74, Michigan P.A. of 1970, the corner points mentioned in lines 1 and 2 above were in conformance with regulations and rules therefore as required in the current manual of survey instructions of the United States Department of the Interior, Bureau of Land Management or by a decree of a Court of Law and/or that the corner points mentioned in lines 3, 4, and 5 above were in conformance with the rules of the Michigan Board of Land Surveyors or by a Decree of a Court of Law; established, re-established, monumented, re-monumented, recovered, found as expressed below.

	A	B	C	D	E	F	G	H	I	J	K	L
2	6		5		4		3		2		1	
3												
4	7		8		9		10		11		12	
5												
6	18		17		16		15		14		13	
7												
8	19		20		21		22		23		24	
9												
10	30		29					27		26		25
11												
12	31		32		33		34		35		36	
13												

NOTE: Not more than 2 corners, all in the same town and range, may be recorded on this certificate.

A. Description of original monument and accessories and/or subsequent restoration:

THIS CORNER NOT SET BY THE GENERAL LAND OFFICE

NO RECORDED HISTORICAL INFORMATION AVAILABLE FOR THIS CORNER

B. Description of corner evidence found and/or method applied in restoring or reestablishing corner:

FOUND NO EVIDENCE OF CORNER MONUMENTATION. TRAVERSE OF ENTIRE SECTION 28 REVEALED 3" HOLLOW CORE TILES AT E-10, F-11, G-10 AND REESTABLISHED POSITION AT F-9. SET CENTER OF SECTION 28 (F-10) AT INTERSECTION OF 1/4 LINES. THIS METHOD FIT EXCEPTIONALLY WELL WITH OCCUPATION THROUGHOUT SECTION.


SET 4" X 36" CONCRETE MONUMENT WITH 1/2" IRON INSIDE AT INTERSECTION OF 1/4 LINES..

C. Description of monument for corner and accessories established to perpetuate locating the position of the corner:

**SET 4" X 36" CONCRETE MONUMENT WITH 1/2" IRON INSIDE FOR CORNER
SET 20d NAIL W/REMON TAG IN THE NORTHWEST SIDE OF A 10" TWIN CHERRY S62°W 7.12'
SET 20d NAIL W/REMON TAG IN THE SOUTHEAST SIDE OF AN 8" TRIPLE CHERRY S49°W 7.61'
SET 20d NAIL W/REMON TAG IN THE SOUTHWEST SIDE OF A 4" HICKORY S38°W 10.18'
SET 20d NAIL W/REMON TAG IN THE WEST SIDE OF AN 8" CHERRY S1°E 13.67'
SET 20d NAIL W/REMON TAG IN THE WEST SIDE OF A 14" CHERRY S1°W 17.76'
SET 20d NAIL W/REMON TAG IN THE WEST SIDE OF A 5" HICKORY S5°E 19.61'
CORNER LIES 0.5' WEST OF A NORTH-SOUTH FENCE SET "T" FENCE POST 0.5' NORTH OF MONUMENT**

ACT 345 BARRY COUNTY REMONUMENTATION
APPROVED BY PEER REVIEW AT A MEETING HELD ON

7-8-96 BR
BRIAN REYNOLDS COUNTY SURVEYOR

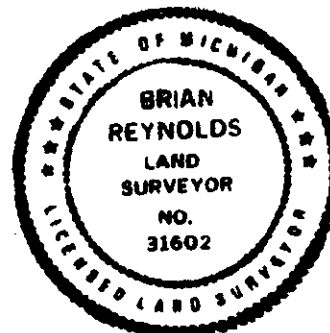

Signed by [Signature]
Surveyor's Michigan License No 31602

Date MAY 16, 1997