

DEC 9 2 10 PM '96

Sandy Schmalzmaier  
 REGISTER OF DEEDS

BARRY COUNTY REMONUMENTATION  
 LAND CORNER RECORDATION CERTIFICATE  
 Filing Requirement of Act 74, Mich. P.A. 1970

For corners in

<u>BARRY COUNTY</u> (County)	Located In:	Corner Code #
	T <u>IN</u> R <u>10W</u>	<u>G-4</u>
1. Public Land Survey	T <u>    </u> R <u>    </u>	<u>    </u>
SEC COR COMMON TO	T <u>    </u> R <u>    </u>	<u>    </u>
SEC'S 9 & 10	T <u>    </u> R <u>    </u>	<u>    </u>
2. Property Controlling	T <u>    </u> R <u>    </u>	<u>    </u>
in Section	S <u>    </u> T <u>    </u> R <u>    </u>	<u>    </u>
3. Miscellaneous	S <u>    </u> T <u>    </u> R <u>    </u>	<u>    </u>
Property in Sec.	S <u>    </u> T <u>    </u> R <u>    </u>	<u>    </u>

SURVEY & **002443**  
 REMONUMENTATION

MAY 20 1997

COMMISSION

Register of Deeds Stamp & File Number

4. Lot No. \_\_\_\_\_, Recorded Plat \_\_\_\_\_  
 5. Private Claims \_\_\_\_\_

I, RAYMOND E. MOORED, in a field survey on Febr 18, 1995 do hereby state that under requirements of P.A. 74, Michigan P.A. of 1970, the corner points mentioned in lines 1 and 2 above were in conformance with regulations and rules therefore as required in the current manual of survey instructions of the United States Department of the Interior, Bureau of Land Management or by a decree of a Court of Law and /or that the corner points mentioned in lines 3, 4 and 5 above were in conformance with the rules of the Michigan Board of Land Surveyors or by a Decree of a Court of Law; established, re-established, monumented, recovered, found as expressed below:

NOTE: Not more than 2 corners, all in the same town and range, may be recorded on this certificate.

	A	B	C	D	E	F	G	H	I	J	K	L	M
1													
2	6		5		4		3		2		1		
3													
4	7		8		9		10		11		12		
5													
6	18		17		16		15		14		13		
7													
8	19		20		21		22		23		24		
9													
10	30		29		28		27		26		25		
11													
12	31		32		33		34		35		36		
13													

A. Description of original monument and accessories and/or subsequent restoration:

G.L.O: SYLVESTER SIBLEY, D.S., 1826 (R10W, P.25)  
 D.O. 30 N75 1/2W 120

CRESSY: OCT. - NOV. 1884 (L.2, P. 252 RESURVEY) FOUND OLD POST & WITNESSES. PUT IN TILE. B. OAK 8 S 57 1/2E. 18 B. OAK 12 S 74W. 60 ROBT. CARR, P.S. # 20704. LCRC # 434 4-4-88 FD. 3" TILE SET 1/2 IRON IN CTR. OF TILE 6" HICKORY N65W 29.12 8" CHERRY S50W, 33.00 8" CHERRY N35E, 28.21 6" ASH N50E, 35.45' IN LINE WITH FENCES NORTH & WEST.


B. Description of corner evidence found and/or method applied in restoring or reestablishing corner:

FD 1/2' IRON PER LCRC #434 BY CARR. ACCEPTED IRON ON BEST AVAILABLE EVIDENCE OF CORNER LOCATION SET STANDARD BARRY CO. REMONUMENTATION IRON WITH CAP IN TILE.

ACT 345 BARRY COUNTY REMONUMENTATION  
 APPROVED BY PEER REVIEW AT A MEETING HELD ON  
9 OCT. 95 BR  
 BRIAN REYNOLDS COUNTY SURVEYOR

C. Description of monument for corner and accessories established to perpetuate locating the position of the corner:

SET STANDARD BARRY COUNTY REMONUMENTATION IRON W/CAP.  
 -IN LINE WITH FENCES NORTH AND WEST.  
 -PK & TAG N. SIDE 20' CHERRY S 60 W 18.20'  
 -PK & TAG W. SIDE 18" MAPLE S 5 W 24.06'  
 -PK & TAG NW SIDE 14" MAPLE N 30 E 14.10  
 -PK & TAG S SIDE 8" MAPLE EAST 9.22

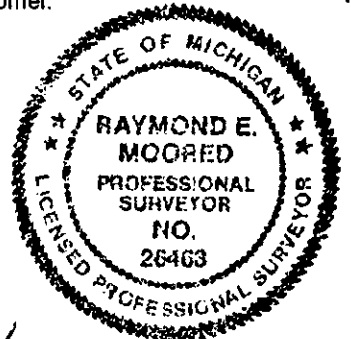

Signed by Raymond E. Moored  
 Surveyor's Michigan License No. 26463

Date 10/7/96