

SURVEY & REMONUMENTATION

JUL 24 1997

COMMISSION

BARRY COUNTY REMONUMENTATION

LAND CORNER RECORDATION CERTIFICATE
Filing Requirement of Act 74, Mich. P.A. 1970

STATE OF MICHIGAN
COUNTY OF BARRY
REC'D

MAR 5 9 26 AM '97

Sandy [Signature]
REGISTER OF DEEDS

For corners in **BARRY**
(County)

Located In:	Corner Code #:
1N 10W	G-10
T _____ R _____	_____
T _____ R _____	_____
T _____ R _____	_____
T _____ R _____	_____
2. Property Controlling S _____ T _____ R _____	_____
in Section S _____ T _____ R _____	_____
3. Miscellaneous S _____ T _____ R _____	_____
Property in Sec. S _____ T _____ R _____	_____

002486

Register of Deeds Stamp & File Number

- 4. Lot No. _____, Recorded Plat _____
- 5. Private Claims _____

	A	B	C	D	E	F	G	H	I	J	K	L	M
2	6	5	4	3	2	1							
3													
4	7	8	9	10	11	12							
5													
6	18	17	16	15	14	13							
7													
8	19	20	21	22	23	24							
9													
10	30	29	28	27	26	25							
11													
12	31	32	33	34	35	36							
13													

BRIAN REYNOLDS 27 JUNE 96

I, _____, in a field survey on _____, 19____, do hereby certify that under requirements of P.A. 74, Michigan P.A. of 1970, the corner points mentioned in lines 1 and 2 above were in conformance with regulations and rules therefore as required in the current manual of survey instructions of the United States Department of the Interior, Bureau of Land Management or by a decree of a Court of Law and/or that the corner points mentioned in lines 3, 4 and 5 above were in conformance with the rules of the Michigan Board of Land Surveyors or by a Decree of a Court of Law; established, re-established, monumented, re-monumented, recovered, found as expressed below.

NOTE: Not more than 4 corners, all in the same town and range, may be recorded on this certificate.

A. Description of original monument and accessories and/or subsequent restoration:

- 1. GENERAL LAND OFFICE: SYLVESTER SIBLEY, D.S., 1826 (R10W,P.22) A B. OAK 30 S65E 50 A B. OAK 16 N88W 52
- 2. COUNTY SURVEYOR RECORDS: JOHN CRESSY, OCT-NOV, 1884 (L.2,P235 RESURVEY) "FOUND OLD POST, PUT IN TILE & TOOK NEW BEARINGS" W. OAK 14 S61W 58 HICKORY 16 S81 1/2E 64 1/2
- 3. COUNTY ROAD COMMISSION: 1973 (ENZIAN RD. FIELD BOOK, P.1) "2 INCH TILE" 10" HICKORY S20°W 15.85' 4" ASH E. 8.85'

NO OTHER RECORDED HISTORICAL INFORMATION AVAILABLE FOR THIS CORNER

B. Description of corner evidence found and/or method applied in restoring or reestablishing corner:


FOUND 3" HOLLOW CORE TILE WITH 3/4" SOLID IRON INSIDE, 1'+/- SOUTH OF A STANDING FENCE LINE RUNNING EAST-WEST. FOUND ONE OLD ROAD COMMISSION WITNESS, HICKORY S20°W 15.85' (MEASURED 16.34'). IN THE 1884 RESURVEY CRESSY RECITES A DISTANCE OF 40.01 CHAINS (2640.66 FEET) TO G-11, MEASURED 2641.46 FEET.

ACCEPTED FOUND TILE AS TRUE CORNER POSITION AS PERPETUATED BY CRESSY.

PLACED STANDARD BARRY COUNTY REMONUMENTATION MONUMENT INSIDE OF FOUND TILE.

ACT 345 BARRY COUNTY REMONUMENTATION
APPROVED BY PEER REVIEW AT A MEETING HELD ON

7-8-96 [Signature] COUNTY SURVEYOR

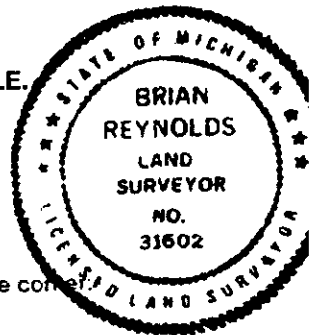

C. Description of monument for corner and accessories established to perpetuate locating the position of the corner:

- SET STANDARD BARRY COUNTY REMONUMENTATION MONUMENT (WITH ALUMINUM CAP)
- SET 20d NAIL W/REMON TAG IN THE NORTHWEST SIDE OF A 14" LEANING CHERRY S50°W 21.99'
- SET 20d NAIL W/REMON TAG IN THE NORTH SIDE OF A 16" CHERRY S86°W 29.24'
- SET 20d NAIL W/REMON TAG IN THE SOUTH SIDE OF A 10" ELM S85°E 27.46'
- FOUND NAIL IN THE SOUTH SIDE OF A 36" CHERRY N90°E 18.98'
- FOUND NAIL IN THE NORTHWEST SIDE OF A 12" HICKORY S23°W 16.34'
- CORNER LIES 106'+/- EAST OF CENTERLINE OF NORTHWEST-SOUTHEAST BITUMINOUS ROADWAY
- 1'+/- SOUTH OF EAST-WEST FENCE LINE

Signed by [Signature]

Date FEB 18, 1997

Surveyor's Michigan License No. 31602