

**SURVEY & REMONUMENTATION**

OCT 25 1993

**COMMISSION**

**BARRY COUNTY REMONUMENTATION  
LAND CORNER RECORDATION CERTIFICATE  
Filing Requirement of Act 74, Mich. P.A. 1970**

STATE OF MICHIGAN  
COUNTY OF BARRY  
RECEIVED FOR RECORD

OCT 20 4:14 PM '93

Sandy Schondelmaier

REGISTER OF DEEDS

**002089**

Register of Deeds Stamp & File Number

For corners in  
**BARRY**

(County)

Located In:

Corner Code #

- |                                    |                            |                     |
|------------------------------------|----------------------------|---------------------|
| 1. Public Land Survey              | T <u>1</u> N R <u>10</u> W | G-11 (NW, 34)       |
|                                    | T _____ R _____            | <u>Prairieville</u> |
|                                    | T _____ R _____            | _____               |
|                                    | T _____ R _____            | _____               |
| 2. Property Controlling in Section | S _____ T _____ R _____    | _____               |
|                                    | S _____ T _____ R _____    | _____               |
| 3. Miscellaneous Property in Sec.  | S _____ T _____ R _____    | _____               |
|                                    | S _____ T _____ R _____    | _____               |

4. Lot No. \_\_\_\_\_, Recorded Plat \_\_\_\_\_  
5. Private Claims \_\_\_\_\_

I, David F. Peabody, in a field survey on August, 19 93, do hereby certify that under requirements of P.A. 74, Michigan P.A. of 1970, the corner points mentioned in lines 1 and 2 above were in conformance with regulations and rules therefore as required in the current manual of survey instructions of the United States Department of the Interior, Bureau of Land Management or by a decree of a Court of Law and/or that the corner points mentioned in lines 3, 4 and 5 above were in conformance with the rules of the Michigan Board of Land Surveyors or by a Decree of a Court of Law; established, re-established, monumented, re-monumented, recovered, found as expressed below:

**NOTE: Not more than 4 corners, all in the same town and range, may be recorded on this certificate.**

	A	B	C	D	E	F	G	H	I	J	K	L	M
2	6		5		4		3		2		1		
3													
4	7		8		9		10		11		12		
5													
6	18		17		16		15		14		13		
7													
8	19		20		21		22		23		24		
9													
10	30		29		28		27		26		25		
11													
12	31		32		33		34		35		36		
13													

A. Description of original monument and accessories and/or subsequent restoration:

G.L.O.:

W. Oak 14 S37E 87  
Do 14 N74W 1.37

Resurvey By Cressy (Deputy Surveyor) 1884  
Found Old Cedar Post (Put in Tile)  
W. Oak 8 N75E 32  
B. Oak 10 S37W 59

Consumers Power Company 1965 ±  
Found Tile 1' Below Surface  
Set "T" Iron to Surface  
40" Oak NE 20.82'  
28" Oak SE 37.60'  
Steel Fence Post West 27.75'  
24" Hickory NE 55.71'  
3' N of E&W Fence  
Approximate  $\frac{1}{2}$  Gravel Road N&S


B. Description of corner evidence found and/or method applied in restoring or reestablishing corner:

Found  $\frac{1}{2}$ " Rerod in Center of 3" Tile  
Steel Fence Post West 27.75'  
3' ± N. of E&W Fence  
14" Triple Oak S20°E 65.1'  
Approximate  $\frac{1}{2}$  Gravel Road N&S  
G.L.O. & Cressy Witnesses were Gone

(over)

C. Description of monument for corner and accessories established to perpetuate locating the position of the corner:

Set  $\frac{3}{4}$ " Iron W/Remon Cap in Center of Tile (Replacing  $\frac{1}{2}$ " Rerod)  
3' ± N. of E&W Fence  
1' ± W. of (Paved)  $\frac{1}{2}$  Road  
Steel Fence Post S85°W 27.75'  
20d Nail W/Barry Co. Tag S. Side 14" Hickory West 42.25'  
20d Nail W/Barry Co., Tag SW Side 8" Wild Cherry S75°E 33.10'  
20d Nail W/Barry Co., Tag SW Side 16" Triple Oak S20°E 65.70'

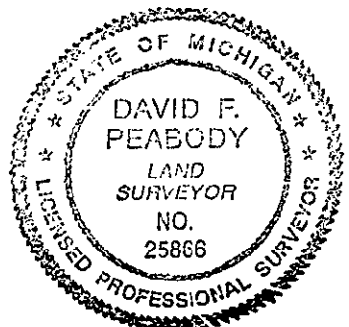

Signed by David F. Peabody

Date 9/17/93

Surveyor's Michigan License No. 25866

filed 10/26/93

A. (Continued)

Dennis Middleton (R.L.S. 16049) 1971

Found "T" Iron on Surface

40" Oak NE 20.82'

28" Oak SE 37.60'

Steel Fen. Post W. 27.75'

24" Hick. NE 55.71'

in Approx.  $\frac{1}{2}$  of N. and S. Gravel Rd.

3'  $\pm$  N. of Fen. to E. and W.

Road Commission (no Date)

FD Iron

Pole S87°E 58.15'

14" Triple Oak S20°E 65.1'

Iron Fen Post W. 27.75'

24" Hickory NE 55.71'

P. Pole S60°E 69.0'

3/20-5