

**SURVEY &  
REMONUMENTATION**

1993

**COMMISSION**

For corners in

BARRY

(County)

**BARRY COUNTY REMONUMENTATION  
LAND CORNER RECORDATION CERTIFICATE  
Filing Requirement of Act 74, Mich. P.A. 1970**

STATE OF MICHIGAN  
COUNTY OF BARRY  
RECEIVED FOR RECORD

JUL 12 12 50 PM '93

Sandy Schondelmayer

REGISTER OF DEEDS

002021

Register of Deeds Stamp & File Number

|                                       |                            |               |
|---------------------------------------|----------------------------|---------------|
| 1. Public Land Survey                 | T <u>1</u> N R <u>10</u> W | G-13 (SW, 34) |
|                                       | T _____ R _____            | Prairieville  |
|                                       | T _____ R _____            | _____         |
|                                       | T _____ R _____            | _____         |
| 2. Property Controlling<br>in Section | S _____ T _____ R _____    | _____         |
|                                       | S _____ T _____ R _____    | _____         |
| 3. Miscellaneous<br>Property in Sec.  | S _____ T _____ R _____    | _____         |
|                                       | S _____ T _____ R _____    | _____         |

4. Lot No. \_\_\_\_\_, Recorded Plat \_\_\_\_\_  
5. Private Claims \_\_\_\_\_


I, David F. Peabody in a field survey on May, 19 93, do hereby certify that under requirements of P.A. 74, Michigan P.A. of 1970, the corner points mentioned in lines 1 and 2 above were in conformance with regulations and rules therefore as required in the current manual of survey instructions of the United States Department of the Interior, Bureau of Land Management or by a decree of a Court of Law and/or that the corner points mentioned in lines 3, 4 and 5 above were in conformance with the rules of the Michigan Board of Land Surveyors or by a Decree of a Court of Law; established, re-established, monumented, re-monumented, recovered, found as expressed below:

**NOTE: Not more than 4 corners, all in the same town and range, may be recorded on this certificate.**

| A  | B  | C  | D  | E  | F  | G  | H | I | J | K | L |
|----|----|----|----|----|----|----|---|---|---|---|---|
| 2  | 6  | 5  | 4  | 3  | 2  | 1  |   |   |   |   |   |
| 3  |    |    |    |    |    |    |   |   |   |   |   |
| 4  | 7  | 8  | 9  | 10 | 11 | 12 |   |   |   |   |   |
| 5  |    |    |    |    |    |    |   |   |   |   |   |
| 6  | 18 | 17 | 16 | 15 | 14 | 13 |   |   |   |   |   |
| 7  |    |    |    |    |    |    |   |   |   |   |   |
| 8  | 19 | 20 | 21 | 22 | 23 | 24 |   |   |   |   |   |
| 9  |    |    |    |    |    |    |   |   |   |   |   |
| 10 | 30 | 29 | 28 | 27 | 26 | 25 |   |   |   |   |   |
| 11 |    |    |    |    |    |    |   |   |   |   |   |
| 12 | 31 | 32 | 33 | 34 | 35 | 36 |   |   |   |   |   |
| 13 |    |    |    |    |    |    |   |   |   |   |   |

A. Description of original monument and accessories and/or subsequent restoration:  
Resurvey By Cressy (Deputy Surveyor) 1884 Chamberlain (1966)  
Found Post (Put in Tile) Pipe in Tile  
B.O. 10 N76W 78 20" Hickory W. 17.5'  
W.O. 6 N31½W 49½ 10" Oak N50°E 13.5'

B. Description of corner evidence found and/or method applied in restoring or reestablishing corner:  
Found Pipe in Tile  
18" Deep  
Per Chamberlain Witnesses Above  
10" Oak N50°E 13.5' is now a Stump

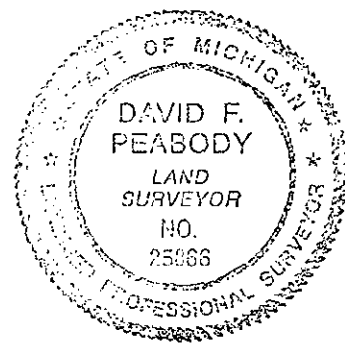

C. Description of monument for corner and accessories established to perpetuate locating the position of the corner:  
Replaced Pipe W/3/4" Iron W/Remon Cap in Center of Tile  
18" Deep  
1.5' S. of E&W Fence  
20d Nail W/Barry Co. Tag S. Side 24" Hickory W. 17.60'  
20d Nail W/Barry Co. Tag S. Side 28" Oak E. 26.73'  
20d Nail W/Barry Co. Tag W. Side 8" Triple W. Cherry N10°W 34.15'  
20d Nail W/Barry Co. Tag N. Side 18" Oak N77°W 40.25'

Signed by David F. Peabody  
Surveyor's Michigan License No. 25866

Date 6/18/93