

DEC 9 2 10 PM '96

Sandy Schendelmar  
 REGISTER OF DEEDS

BARRY COUNTY REMONUMENTATION  
 LAND CORNER RECORDATION CERTIFICATE  
 Filing Requirement of Act 74, Mich. P.A. 1970

For corners in

BARRY COUNTY  
 (County)

Located In: Corner Code #

- |                                    |   |    |     |     |
|------------------------------------|---|----|-----|-----|
| 1. Public Land Survey              | T | 1N | 10W | H-3 |
|                                    | T | R  |     |     |
| SEC COR COMMON TO                  | T | R  |     |     |
| SEC'S 3 & 10                       | T | R  |     |     |
| 2. <del>Property Controlling</del> | S | T  | R   |     |
| in Section                         | S | T  | R   |     |
| 3. Miscellaneous                   | S | T  | R   |     |
| Property in Sec.                   | S | T  | R   |     |

002445

Register of Deeds Stamp & File Number

4. Lot No. \_\_\_\_\_, Recorded Plat \_\_\_\_\_  
 5. Private Claims \_\_\_\_\_

I, RAYMOND E. MOORED, in a field survey on MARCH, 1995 do hereby state that under requirements of P.A. 74, Michigan P.A. of 1970, the corner points mentioned in lines 1 and 2 above were in conformance with regulations and rules therefore as required in the current manual of survey instructions of the United States Department of the Interior, Bureau of Land Management or by a decree of a Court of Law and for that the corner points mentioned in lines 3, 4 and 5 above were in conformance with the rules of the Michigan Board of Land Surveyors or by a Decree of a Court of Law; established, re-established, monumented, recovered, found as expressed below:

NOTE: Not more than 2 corners, all in the same town and range, may be recorded on this certificate.

A	B	C	D	E	F	G	H	I	J	K	L	M
1												
2	6		5		4		3		2		1	
3							●					
4	7		8		9		10		11		12	
5												
6	18		17		16		15		14		13	
7												
8	19		20		21		22		23		24	
9												
10	30		29		28		27		26		25	
11												
12	31		32		33		34		35		36	
13												

A. Description of original monument and accessories and/or subsequent restoration:

G.L.O: SYLVESTER SIBLEY, D.S., 1826 (R10W, P.25)  
 A.W. 8 S. 63 W. 5 D.O. 7. S62 E. 20

CRESSY OCT.-NOV. 1884 (L2, P. 252 RESURVEY) STAKE & STONE FOUND IN TILE & TOOK BEARINGS. B. OAK 12 S 77W  
 180 HICKORY 8 N88E 242

B. Description of corner evidence found and/or method applied in restoring or reestablishing corner:


FOUND BLACK OAK AND HICKORY WITNESSES PER CRESSY SURVEY. TILE GONE DUE TO CUT SECTION IN ROAD. CROSSED WITNESSES AND SET STANDARD BARRY COUNTY REMONUMENTATION IRON WITH CAP AT THIS LOCATION. ACCEPTED THIS AS BEST AVAILABLE POSITION FOR THIS CORNER.

ACT 345 BARRY COUNTY REMONUMENTATION  
 APPROVED BY PEER REVIEW AT A MEETING HELD ON  
9 OCT. '95 BR  
 BRIAN REYNOLDS COUNTY SURVEYOR

C. Description of monument for corner and accessories established to perpetuate locating the position of the corner:

- SET STANDARD BARRY COUNTY REMONUMENTATION IRON W/CAP.
- NAIL IN N. SIDE 50" W. OAK S. 77W 118.70
- NAIL IN SE SIDE 24" HICKORY N88E 160.70'
- NAIL IN NW SIDE 30" W. OAK N40E 24.58'
- NAIL IN E SIDE 14" HICKORY SOUTH 33.98
- CENTERLINE ROAD 6' SOUTH
- TREE LINE AND NEW FENCE TO SOUTH IS 3'+/- EAST

SURVEY &  
 REMONUMENTATION  
 MAY 20 1997  
 COMMISSION

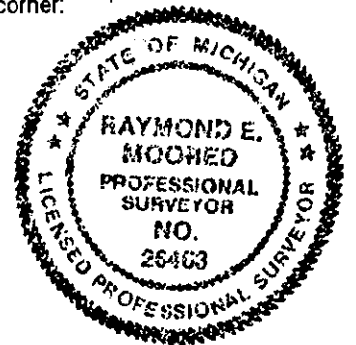

Signed by Raymond E. Moored  
 Surveyor's Michigan License No. 26463

Date 10/7/96