

SURVEY & REMONUMENTATION

1993

COMMISSION

**BARRY COUNTY REMONUMENTATION
LAND CORNER RECORDATION CERTIFICATE**

Filing Requirement of Act 74, Mich. P.A. 1970

STATE OF MICHIGAN
COUNTY OF BARRY
RECEIVED FOR RECORD

JUL 12 12 50 PM '93

Sandy Schondelmayer
REGISTER OF DEEDS

002022

Register of Deeds Stamp & File Number

For corners in

<u>BARRY</u> (County)	Located In:	Corner Code #
1. Public Land Survey	T <u>1N</u> R <u>10W</u>	<u>H-13(S$\frac{1}{4}$, 34)</u> <u>Prairieville</u>
	T ___ R ___	_____
	T ___ R ___	_____
	T ___ R ___	_____
2. Property Controlling in Section	S ___ T ___ R ___	_____
	S ___ T ___ R ___	_____
3. Miscellaneous Property in Sec.	S ___ T ___ R ___	_____
	S ___ T ___ R ___	_____

4. Lot No. _____, Recorded Plat _____
5. Private Claims _____

I, David F. Peabody, in a field survey on May, 1993, do hereby certify that under requirements of P.A. 74, Michigan P.A. of 1970, the corner points mentioned in lines 1 and 2 above were in conformance with regulations and rules therefore as required in the current manual of survey instructions of the United States Department of the Interior, Bureau of Land Management or by a decree of a Court of Law and/or that the corner points mentioned in lines 3, 4 and 5 above were in conformance with the rules of the Michigan Board of Land Surveyors or by a Decree of a Court of Law; established, re-established, monumented, re-monumented, recovered, found as expressed below:

NOTE: Not more than 4 corners, all in the same town and range, may be recorded on this certificate.

	A	B	C	D	E	F	G	H	I	J	K	L
2	6	5	4	3	2	1						
3												
4	7	8	9	10	11	12						
5												
6	16	17	16	15	14	13						
7												
8	19	20	21	22	23	24						
9												
10	30	29	28	27	26	25						
11												
12	31	32	33	34	35	36						
13												


A. Description of original monument and accessories and/or subsequent restoration:

G.L.O.:
W. Oak 8 N84 $\frac{1}{2}$ E 27
Do. 14 N15W 81
Resurvey By Cressy (Deputy Surveyor) 1884
Found Post (Put in Tile)
Hickory 10 N76°W 78
W.O. 6 N31 $\frac{1}{2}$ W 49 $\frac{1}{2}$

Consumers Power Company 1965 ±
Found Tile, Set "T" Iron in Center
24" Oak W. 48.56'
17" Oak N. 15.99'
14" W. Cherry SE 7.05'
W. face 30" Oak E. 3'±
1' N. of E&W Fence
Approximately in Line W/Fence N. if extended South

B. Description of corner evidence found and/or method applied in restoring or reestablishing corner:

Found "T" Iron in Center of Tile
Per Consumers Power Company Witnesses above (All)

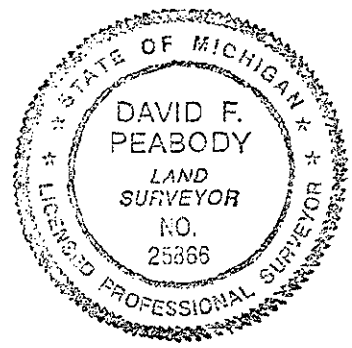

C. Description of monument for corner and accessories established to perpetuate locating the position of the corner:

Replaced "T" Iron W/3/4" Iron W/Remon Cap in Center of Tile
0.5'± N. of E&W Fence
Approximately in Line W/Fence N. if Extended South
20d Nail W/Barry Co. Tag NW Side 36" Oak E. 4,13'
20d Nail W/Barry Co. Tag W. Side 24" Oak N. 16.08'
20d Nail W/Barry Co. Tag SW Side 22" W. Cherry S30°E 7.58'
20d Nail W/Barry Co. Tag N. Side 30" Oak W. 48.53'

Signed by David F. Peabody Date 6/18/93
Surveyor's Michigan License No. 25866