

DEC 9 2 10 PM '96

BARRY COUNTY REMONUMENTATION  
 LAND CORNER RECORDATION CERTIFICATE  
 Filing Requirement of Act 74, Mich. P.A. 1970

Sandy Schindelmayer  
 REGISTER OF DEEDS

For corners in

<u>BARRY</u> (County)	Located In:	Corner Code #
1. Public Land Survey COR COMMON TO SEC'S 2, 3, 10, & 11 PRAIRIEVILLE TWP.	T <u>1</u> N <u>R</u> 10 W	<u>I-3</u>
	T <u>   </u> R <u>   </u>	<u>   </u>
	T <u>   </u> R <u>   </u>	<u>   </u>
	T <u>   </u> R <u>   </u>	<u>   </u>
2. Property Controlling in Section	S <u>   </u> T <u>   </u> R <u>   </u>	<u>   </u>
	S <u>   </u> T <u>   </u> R <u>   </u>	<u>   </u>
3. Miscellaneous Property in Sec.	S <u>   </u> T <u>   </u> R <u>   </u>	<u>   </u>
	S <u>   </u> T <u>   </u> R <u>   </u>	<u>   </u>

002447

Register of Deeds Stamp & File Number

4. Lot No. \_\_\_\_\_, Recorded Plat \_\_\_\_\_  
 5. Private Claims \_\_\_\_\_

I, RAYMOND MOORED, in a field survey on FEB. 7, 1996 do hereby state that under requirements of P.A. 74, Michigan P.A. of 1970, the corner points mentioned in lines 1 and 2 above were in conformance with regulations and rules therefore as required in the current manual of survey instructions of the United States Department of the Interior, Bureau of Land Management or by a decree of a Court of Law and/or that the corner points mentioned in lines 3, 4 and 5 above were in conformance with the rules of the Michigan Board of Land Surveyors or by a Decree of a Court of Law, established, re-established, monumented, recovered, found as expressed below:

	A	B	C	D	E	F	G	H	I	J	K	L	M
1													
2		6		5		4		3		2		1	
3									●				
4		7		8		9		10		11		12	
5													
6		18		17		16		15		14		13	
7													
8		19		20		21		22		23		24	
9													
10		30		29		28		27		26		25	
11													
12		31		32		33		34		35		36	
13													

NOTE: Not more than 2 corners, all in the same town and range, may be recorded on this certificate.

A. Description of original monument and accessories and/or subsequent restoration:

G.L.O.: Sylester Sibley D.S. 1826 (R10W, P.20) A.W. Oak 18 N73W  
 80 Do 18 S59W 69

CRESSY: 1884 (oct.-Nov.)  
 PRAIRIEVILLE RESURVEY (L2 P. 251)  
 Found old stake & stone, Put in tile Hickory 8 N5E 27 W. Oak 22 S78W 172.

B. Description of corner evidence found and/or method applied in restoring or reestablishing corner:


FOUND 1/2" IRON AT CORNER LOCATION. FURTHER INVESTIGATION DETERMINED THAT IRON WAS SET BY GREG JENSEN PS# 31593. JENSEN DETERMINED THAT HICKORY TREE TO NORTH OF CORNER LOCATION WAS WITNESS TREE RECORDED BY CRESSEY. JENSEN USED WITNESS CALL AND MEASUREMENTS TO OCCUPATION TO SET CORNER. ACCEPTED THIS POSITION AS BEST AVAILABLE EVIDENCE OF CORNER LOCATION.

ACT 345 BARRY COUNTY REMONUMENTATION  
 APPROVED BY PEER REVIEW AT A MEETING HELD ON

9 OCT '95 BR  
 BRIAN REYNOLDS COUNTY SURVEYOR

C. Description of monument for corner and accessories established to perpetuate locating the position of the corner:

SET STANDARD BARRY COUNTY REMON IRON WITH CAP  
 -NORTH AND SOUTH FENCE LINE WEST 45'  
 -20DNAIL IN W SIDE 28" HICKORY N3DEG E 18.42'  
 -20D NAIL IN SW SIDE P. POLE N45DEG. W 57.97'  
 -20D NAIL IN W SIDE 6" ASH S30DEG E 28.74'  
 -20D NAIL IN W SIDE 8" ASH S30DEG E 43.9'

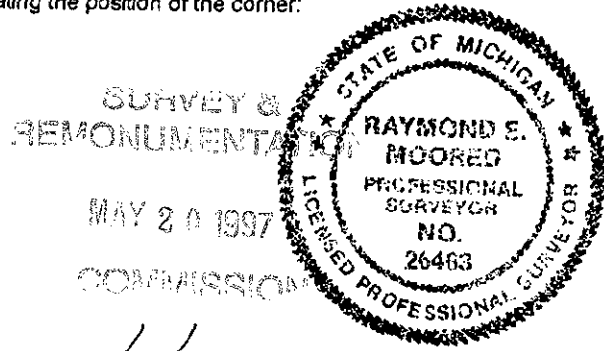

Signed by Raymond Moored  
 Surveyor's Michigan License No. 26463

Date 11/4/96