

STATE OF MICHIGAN  
COUNTY OF BARRY  
RECORDS DEPARTMENT

DEC 9 2 10 PM '96

Sandy Schindelmayer  
REGISTER OF DEEDS

BARRY COUNTY REMONUMENTATION  
LAND CORNER RECORDATION CERTIFICATE  
Filing Requirement of Act 74, Mich. P.A. 1970

For corners in

<u>BARRY</u> (County)	Located In:	Corner Code =#
1. Public Land Survey	T <u>1N</u> R <u>10</u> W	<u>I-4</u>
1/4 CORNER COMMON TO	T _____ R _____	_____
SECTIONS 10&11	T _____ R _____	_____
PRAIREVILLE RWP.	T _____ R _____	_____
2. Property Controlling	S _____ T _____ R _____	_____
in Section	S _____ T _____ R _____	_____
3. Miscellaneous	S _____ T _____ R _____	_____
Property in Sec.	S _____ T _____ R _____	_____

002448

Register of Deeds Stamp & File Number

4. Lot No. \_\_\_\_\_, Recorded Plat \_\_\_\_\_  
5. Private Claims \_\_\_\_\_

A	B	C	D	E	F	G	H	I	J	K	L	M
2	6	5	4	3	2	1						
3												
4	7	8	9	10	11	12						
5												
6	18	17	16	15	14	13						
7												
8	19	20	21	22	23	24						
9												
10	30	29	28	27	26	25						
11												
12	31	32	33	34	35	36						
13												

I, RAYMOND MOORED, in a field survey on FEBURARY 7, 19 95, do hereby certify that under requirements of P.A. 74, Michigan P.A. of 1970, the corner points mentioned in lines 1 and 2 above were in conformance with regulations and rules therefore as required in the current manual of survey instructions of the United States Department of the Interior, Bureau of Land Management or by a decree of a Court of Law and/or that the corner points mentioned in lines 3, 4 and 5 above were in conformance with the rules of the Michigan Board of Land Surveyors or by a Decree of a Court of Law; established, re-established, monumented, re-monumented, recovered, found as expressed below:

**NOTE: Not more than 4 corners, all in the same town and range, may be recorded on this certificate.**

A. Description of original monument and accessories and/or subsequent restoration:

G.L.O.: Sylvester Sibley, D.S. 1825 (R10W, P.20)  
A.W OAK 15 S 7 E. 11 DO 8 N4W 36

Cressy Oct. - Nov. 1884 (L.2, P. 251 Resurvey)  
Found old post and 1 witness. Put in tile took new bearings.  
Hickory 6 S 61 W 221/2 B. oak 30-20W 45

B. Description of corner evidence found and/or method applied in restoring or reestablishing corner:

SURVEY &  
REMONUMENTATION  
MAY 20 1997  
COMMISSION


FOUND CONC MONUMENT AS SET BY REYNOLDS. REYNOLDS FOUND TILE BY CRESSEY SET MONUMENT IN PLACE OF TILE. ACCEPTED POSITION AS BEST AVAILABLE EVIDENCE OF CORNER LOCATION. PLACED REMON CAP ON EXISTING MONUMENT.

ACT 345 BARRY COUNTY REMONUMENTATION  
APPROVED BY PEER REVIEW AT A MEETING HELD ON

9 OCT. '95 TSR  
BRIAN REYNOLDS COUNTY SURVEYOR

C. Description of monument for corner and accessories established to perpetuate locating the position of the corner:

4" X 36" CONC. MONUMENT WITH BARRY COUNTY REMON CAP  
-20D NAIL IN WEST SIDE 15" HICKORY S 1°-W 6.76'  
-20D NAIL IN WEST SIDE 40" HICKORY SOUTH 16.93'  
-20D NAIL IN NORTH SIDE 10" HICKORY EAST 44.11'  
-20D NAIL IN NORTH SIDE 30" OAK WEST 78.34'  
-WEST EDGE OF PAVED DRIVE EAST 24.4'

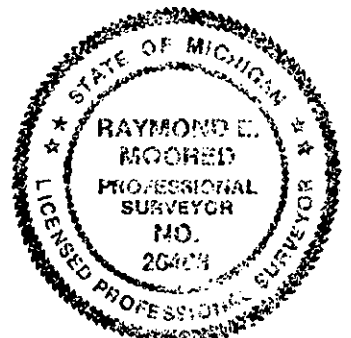

Signed by Raymond Moored  
Surveyor's Michigan License No. 26463

Date 11/4/96