BARRY COUNTY REMONUMENTATION
LAND CORNER RECORDATION CERTIFICATE
FILING REQUIREMENT OF ACT 74, MICH. P. A. 1970

SURVEY & REMONUMENTATION
APR 04 2000
SECTION

2822
Page: 1 of 2
12/07/1999 08:36A
Darla K. Burghdoff- Barry Co. LCRCR
REGISTER OF DEEDS STAMP & FILE NUMBER

FOR CORNERS IN: BARRY COUNTY	LOCATED IN:		CORNER CODE #
1. Public Land Survey	T. 1N	R. 10W	I-9
CORNER COMMON TO SECTIONS 22, 23, 26 & 27 PRAIRIEVILLE TOWNSHIP	T.....	R.....	.....
	T.....	R.....	.....
	T.....	R.....	.....
2. Property Controlling in section	S.....T.....	R.....	.....
	S.....T.....	R.....	.....
3. Miscellaneous Property in Sec.	S.....T.....	R.....	.....

4. Lot No.....,Recorded Plat.....

5. Private Claims.....

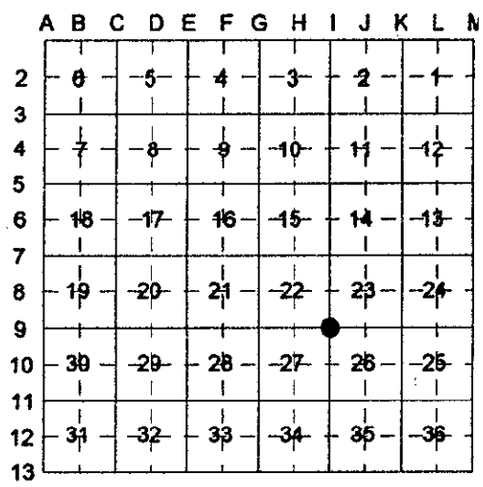

I, Raymond Moored in a field survey on Sept. 23, 1999 do hereby state that under requirments of P.A 74,Michigan P.A of 1970, corner points mentioned in lines 1and 2 above were in conformance with regulations and rules therefore as required in the current manual of survey instructions of the United States Department of the Interior Bureau of Land management or by a decree of a Court of Law and/or that the corner points mentioned in the lines3, 4, and 5 above were in comformance with the rules of the Michigan Board of Land Surveyors or by a Decree of a Court of Law established, monumented, recovered, found as expressed below.

Note: Not more than 2 corners, all the same town and range, may be recorded on this certificate.

A.Description of original monument and accessories and/or subsequent restoration:

SEE BACK OF FORM FOR CORNER HISTORY

ACT 345 BARRY COUNTY REMONUMENTATION
APPROVED BY PEER REVIEW AT A MEETING HELD ON
11 Oct 99 BR
BRIAN REYNOLDS COUNTY SURVEYOR

B.Description of corner evidence found and/or methid applied in restoring or reestablishing corner:

FOUND 3" TILE PER NO'S 4, 6, AND 7 ABOVE.

SET STANDARD BARRY COUNTY REMONUMENTATION IRON WITH CAP IN CENTER OF CLAY TILE

THIS POSITION ACCEPTED AS A CAREFUL AND FAITHFUL REESTABLISHMENT OF THE POSITION OF THE ORIGINAL CORNER.

APPROVED BY BARRY COUNTY REMONUMENTATION PEER GROUP ON _____.

C.Description of monument for corner and accessories established to perpetuate locating the position of the corner:

SET STANDARD BARRY CO. REMONUMENTATION IRON WITH ALUM. CAP IN CENTER OF 3" CLAY TILE

-FD. 1" PIPE 6" HIGH ON E. SIDE OF TILE
-FACE OF 30" OAK STUMP N80E 5.1'
-FACE 20" OAK (DEAD) N70W 10.5'
-NAIL IN N SIDE 10" HICKORY N65E 17.22'
-NAIL IN S SIDE 8" CHERRY S70E 29.80'
-NAIL IN SW SIDE 10" HICKORY N35W 15.82'
-FACE OF 4" HICKORY N55W 1.15'
-COR IS 307' WEST OF CONC FENCE POST NEAR FIELD DRIVE AT CORNER OF WOODS
-EDGE OF FIELD LINE TO NORTH IS EAST 54'+/-

Raymond Moored Date 11/10/99

Surveyors License No. 26463

STATE OF MICHIGAN
RAYMOND E. MOORED
PROFESSIONAL SURVEYOR
NO. 26463
LICENSED PROFESSIONAL SURVEYOR