

MAY 2 1997

COMMISSION

BARRY COUNTY REMONUMENTATION LAND CORNER RECORDATION CERTIFICATE Filing Requirement of Act 74, Mich. P.A. 1970

STATE OF MICHIGAN COUNTY OF BARRY RECEIVED FOR RECORD

DEC 7 1 55 PM '93

Sandy Schondelmayer REGISTER OF DEEDS

002094

Register of Deeds Stamp & File Number

For corners in

Table with columns: BARRY (County), Located In:, Corner Code #. Rows include Public Land Survey, Property Controlling in Section, Miscellaneous Property in Sec.

4. Lot No. , Recorded Plat
5. Private Claims

I, David F. Peabody, in a field survey on September, 19 93, do hereby certify that under requirements of P.A. 74, Michigan P.A. of 1970, the corner points mentioned in lines 1 and 2 above were in conformance with regulations and rules therefore as required in the current manual of survey instructions of the United States Department of the Interior, Bureau of Land Management or by a decree of a Court of Law and/or that the corner points mentioned in lines 3, 4 and 5 above were in conformance with the rules of the Michigan Board of Land Surveyors or by a Decree of a Court of Law; established, re-established, monumented, re-monumented, recovered, found as expressed below:

NOTE: Not more than 4 corners, all in the same town and range, may be recorded on this certificate.

A. Description of original monument and accessories and/or subsequent restoration:

G.L.O.:

- W. Oak 24 S30E 39
B. Oak 16 S79W 66

- Consumers Power Company 1965±
Found Tile Set Iron
Hickory S37W 20.15'
Maple N89W 32.73'
Oak S16 1/2W 19.78'
Twin Hickory S1 1/2E 40.60'

- Resurvey By Cressy (Deputy Surveyor) 1884
Found Old Bearings & Stake (Put in Tile)
Hickory 6 S13E 26
Maple 10 N82 1/2W 50


B. Description of corner evidence found and/or method applied in restoring or reestablishing corner:

- Found 3/4" Pipe (I.D.) in Tile
Maple 10 N82 1/2W 50 (Cressy)
Hickory S37W 20.15'
Maple N89W 32.73' (Fallen Tree)
Oak S16 1/2W 19.78'
Twin Hickory S1 1/2E 40.60'

C. Description of monument for corner and accessories established to perpetuate locating the position of the corner:

- Set 3/4" Iron W/Remon Cap in Center of Tile (Replacing 3/4" Pipe)
10' ± S. of S. Edge of Indian Lake
20d Nail W/Barry Co. Tag, NW Side 30" Oak S20°W 19.70'
20d Nail W/Barry Co. Tag, E'LY Side 24" Twin Hickory S8°E 26.10'
20d Nail W/Barry Co. Tag, NW Side 18" Hickory S37°W 19.80'
20d Nail W/Barry Co. Tag, S. Side 6" W. Cherry N50°W 5.42'

Grid table with columns A-M and rows 2-13. An arrow points to cell J11.

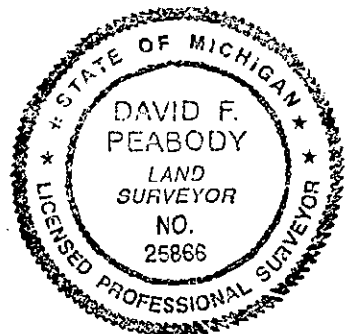

Signed by David F. Peabody Date 11/08/93
Surveyor's Michigan License No. 25866